



City of Prince George  
**History Sheet**

PID:	023428210
MU:	101923
WO:	

Civic Address: 1814 Spruce Street

Legal Description: Lot: PCL 1 District Lot: 343 Plan: PGP40004


Service Type	Diameter (mm)	Material	Invert Elev at main (m)	Invert Elev at property line (m)	Invert Depth at service end (m)	Distance into property (m)	Installation Date
Sanitary	100mm	Unknown	-	568.89	1.98	-	October 1965
Water (W1)	20mm	Copper	-	-	-	-	July 2017
Water (W2)	100mm	PVC	-	-	-	-	July 2017
Storm	100mm	PVC	-	-	-	-	July 2017

Service Connection Location				Sanitary (m)	Storm (m)
Distance from downstream San MH	3174	towards upstream San MH	3279	4.44	
100mm Storm service connected to Stm MH					

Power	Size	Communications	Size	Cable	Size	Gas	Size
BC Hydro	-	Telus	-	Shaw	-	FortisBC	-
Overhead Service		Overhead Service		Overhead Service			

Installed by:	City of Prince George forces	Survey Date:	-
Comments:			

**NOT TO SCALE** The information contained herein is for internal use only.  
Not to be relied on unless confirmed by site inspection and/or investigation.

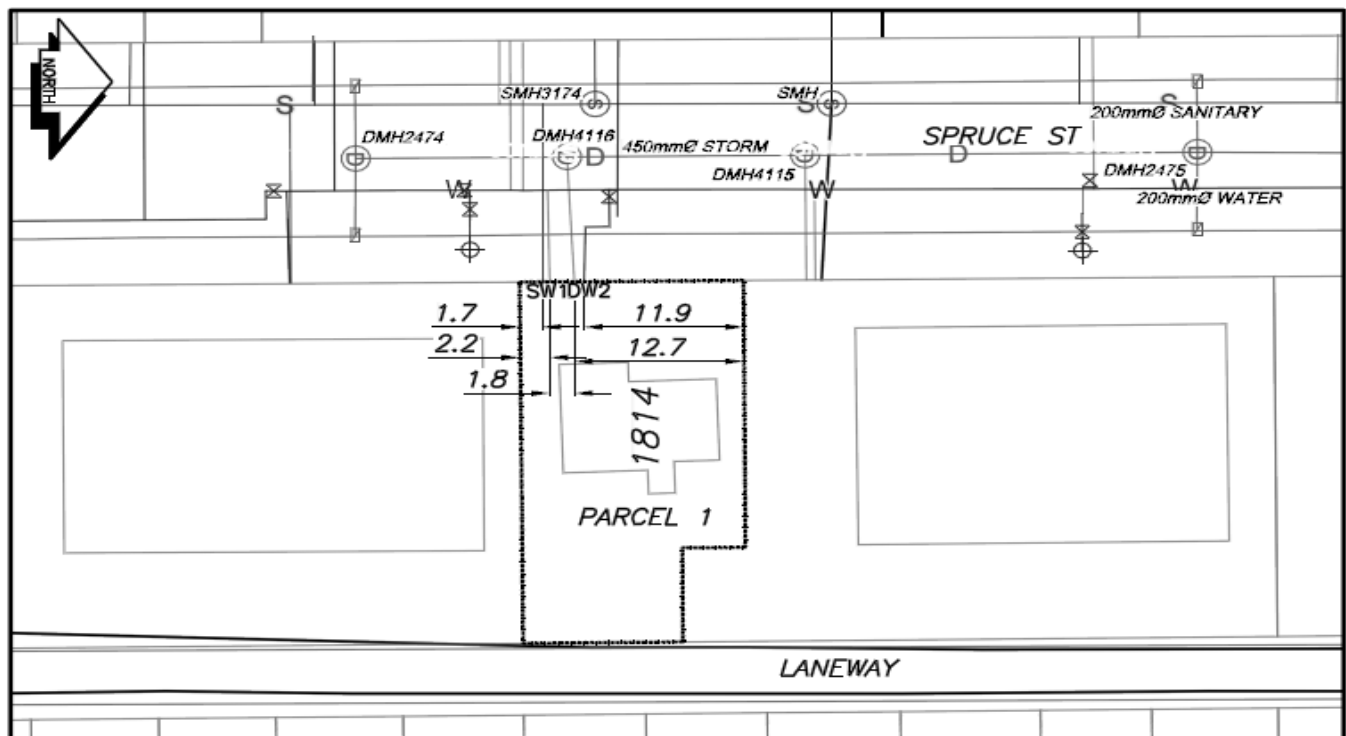

CS CURB STOP	WATER SERVICE	STORM SERVICE
CO CLEAN OUT	SANITARY SERVICE	GAS
WATER VALVE	FIRE HYDRANT	ENCUMBRANCE

**NOT TO SCALE**