


## Lot Servicing

944 FOREMAN RD

PID: 023439963

**Lot: 1, Plan: PGP40062, DL: 954**

SERVICE	SIZE	MATERIAL	INSTALLED DATE	LOCATION	DETAILS
WATER	20MM	CU		17.7M S OF NW COR PL	CASH RECEIPT NUMBER 18056
SANITARY	100MM	PVC		16.7M S OF NW COR PL	RECEIPT # 18056

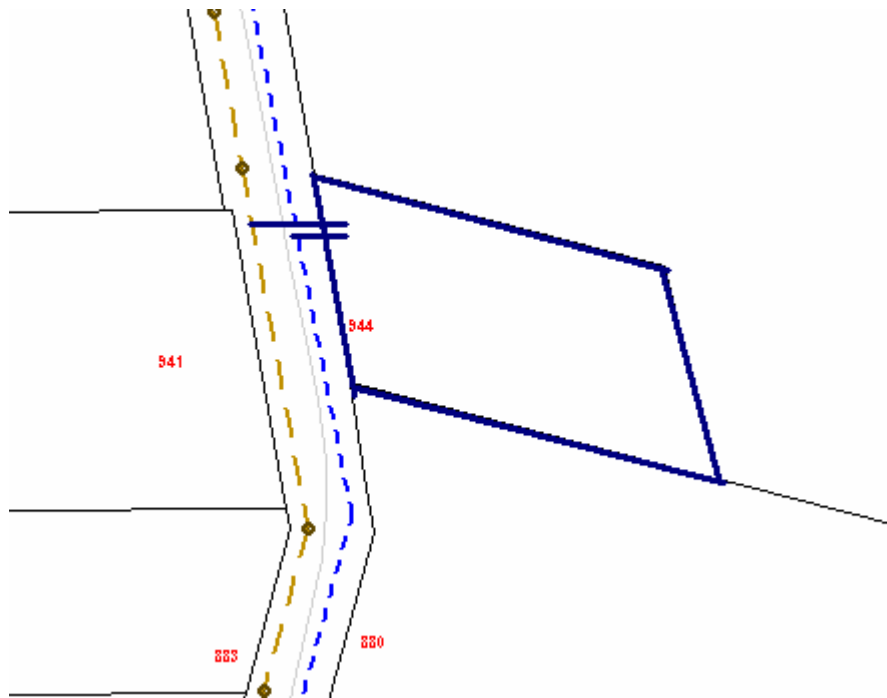

Accuracy not guaranteed unless confirmed by site inspection and/or investigation.  
Connection location between main and property line only.