

**City of Prince George
HISTORY SHEET**

SHEET NUMBER

Roll Number **023450908**

Legal: LOT'S **3** BLOCK D.L. **754** PLAN **40132**

Address: **2681 MARLEAU RD.**

Sanitary Connection: # SIZE **100mm** MATERIAL **PVC** INV. CONNECTED

Water Connection # SIZE **20mm** MATERIAL **CU** METER CONNECTED

Storm Connection: # SIZE **100mm** MATERIAL **PVC** INV. CONNECTED

Cash Receipt No's: WATER SANITARY STORM

CURB FROM PROPERTY LINE PAVEMENT WIDTH **10.000 m**

B.C. HYDRO **O/H** UNDERGROUND CONNECTION

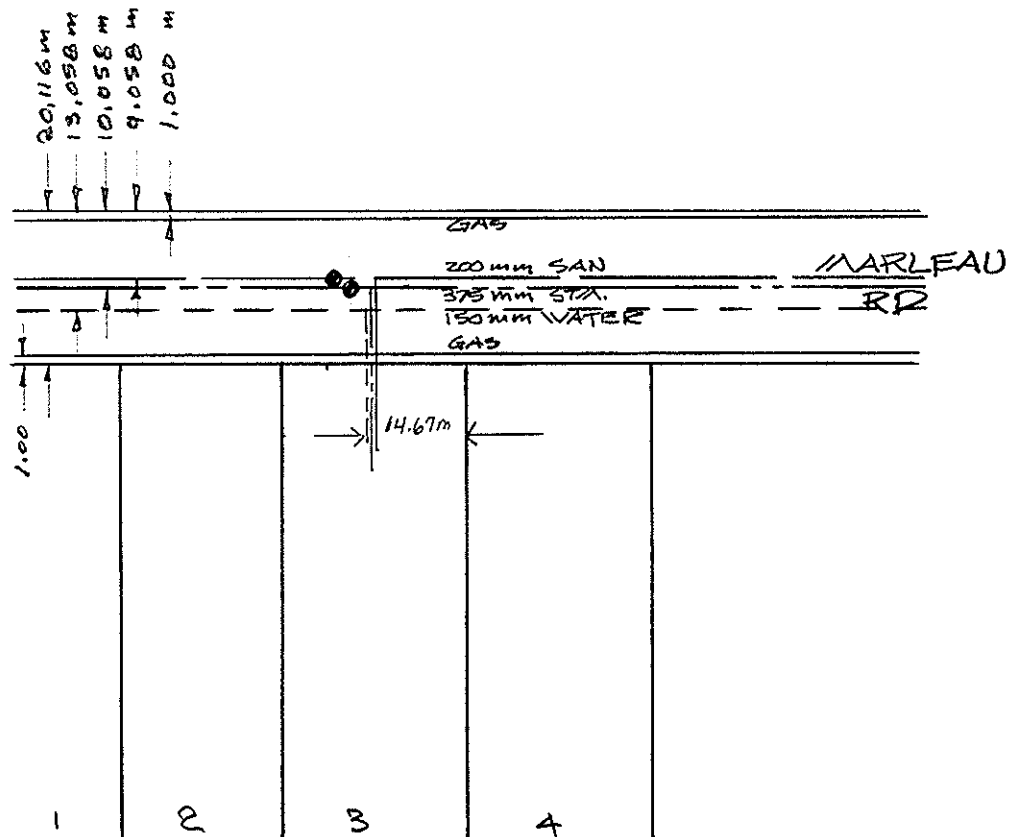
B.C. TELEPHONE **O/H** UNDERGROUND CONNECTION

INLAND GAS **AS SHOWN**

Information Sheets:

Comments:

**THE INFORMATION CONTAINED HEREIN IS FOR INTERNAL USE ONLY.
NOT TO BE RELIED UPON UNLESS CONFIRMED BY SITE INSPECTION AND/OR INVESTIGATION**



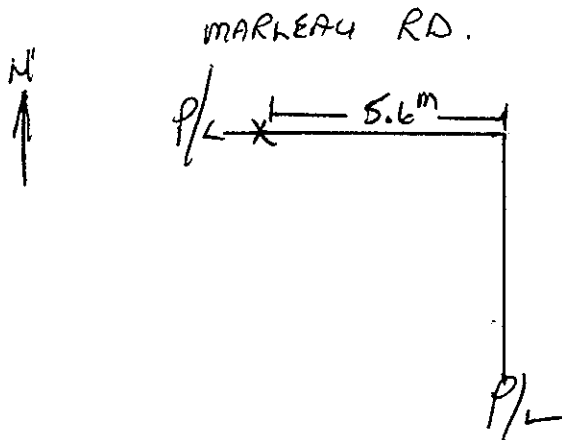
REPORT TO RECORDS

WATER SERVICE INFORMATION

Lot No. _____ Block _____ D.L. _____

Address 2681 MARLEAU RD.Size of Connection ☐ 1/2" ☒ 3/4" ☐ Other _____Type of Connection ☒ Copper ☐ IronThaw Wire ☒ Yes ☐ No

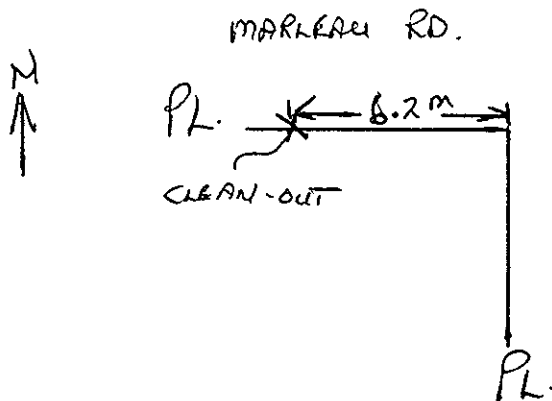
LOCATION SKETCH

Field Location By L. Panko Date OCT 18/00

Checked by: _____

REPORT TO RECORDS

SEWER SERVICE INFORMATION

Lot No. 3-754-40132 Block _____ D.L. _____Address 2681 MARLEAU RD.Size of Connection ☒ 100mm ☐ 150mm ☐ 200mm ☐ Other _____Type of Connection ☐ Transite ☒ PVC ☐ Other _____Type of Cap ☐ Transite ☒ Cast Iron**LOCATION SKETCH**Field Location By L. Panko Date Oct. 18/00

Checked by Foreman - Sewer Division _____