

4

City of Prince George HISTORY SHEET

023 46476
PID 23464984

SHEET NUMBER

Roll Number

Legal: LOT'S 4 BLOCK D.L. 343 PLAN P6P40122

Address: IMPERIAL OIL / 1500 BULK / 1991 RIVER ROAD

Sanitary Connection: # 14332 SIZE 2" X 250mm MATERIAL INV. CONNECTED

Water Connection # 1177B SIZE 50mm MATERIAL Copper METER CONNECTED YES

Storm Connection: # SIZE MATERIAL INV. CONNECTED

Cash Receipt No's: WATER 14332 0841 SANITARY STORM

CURB FROM PROPERTY LINE

PAVEMENT WIDTH

B.C. HYDRO O/H UNDERGROUND CONNECTION

B.C. TELEPHONE O/H UNDERGROUND CONNECTION

INLAND GAS AS SHOWN

Information Sheets:


Comments: FOR MORE INFORMATION SEE ENG DWG. 3650

SITE

PLAN

N.T.S.

RIVER ROAD.

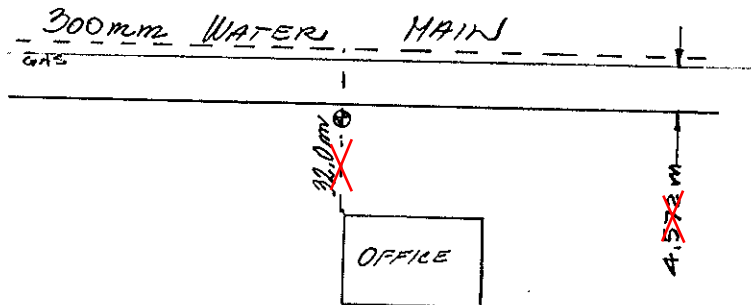

Nov 24, 2011

MU101230 Decommissioning of site & servicing (WO 61130):

Two 10" (250 mm) water lines have been cut/capped and buried.

One 2" (50mm) water line to the office has been shut off and lowered;
(office building has been vacated).