



City of Prince George History Sheet

PID:	023494093
SD/MU:	
WO:	

Civic Address: 5458 Woodoak Cres

Legal Description: Lot: 27 District Lot: 2425 Plan: PGP40290


Service Type	Diameter (mm)	Material	Invert Elev at main (m)	Invert Elev at property line (m)	Invert Depth at service end (m)	Distance into property (m)	Installation Date
Sanitary	100mm	PVC	763.39	763.85	2.19	-	December 1995
Water	20mm	Copper	-	-	-	-	December 1995
Storm	100mm	PVC	-	763.85	-	-	December 1995

Service Connection Location				Sanitary (m)	Storm (m)
Distance from downstream San MH	63	towards upstream San MH	61	54.20	
Distance from downstream Stm MH	2975	towards upstream Stm MH	2972		51.75

Power	Size	Communications	Size	Cable	Size	Gas	Size
BC Hydro	-	Telus	-	Shaw	-	FortisBC	-
Underground Service		Underground Service		Underground Service			

Installed by:		Survey Date:	-
Comments:	Water and Sanitary location confirmed May 31, 2017		

NOT TO SCALE The information contained herein is for internal use only.
Not to be relied on unless confirmed by site inspection and/or investigation.

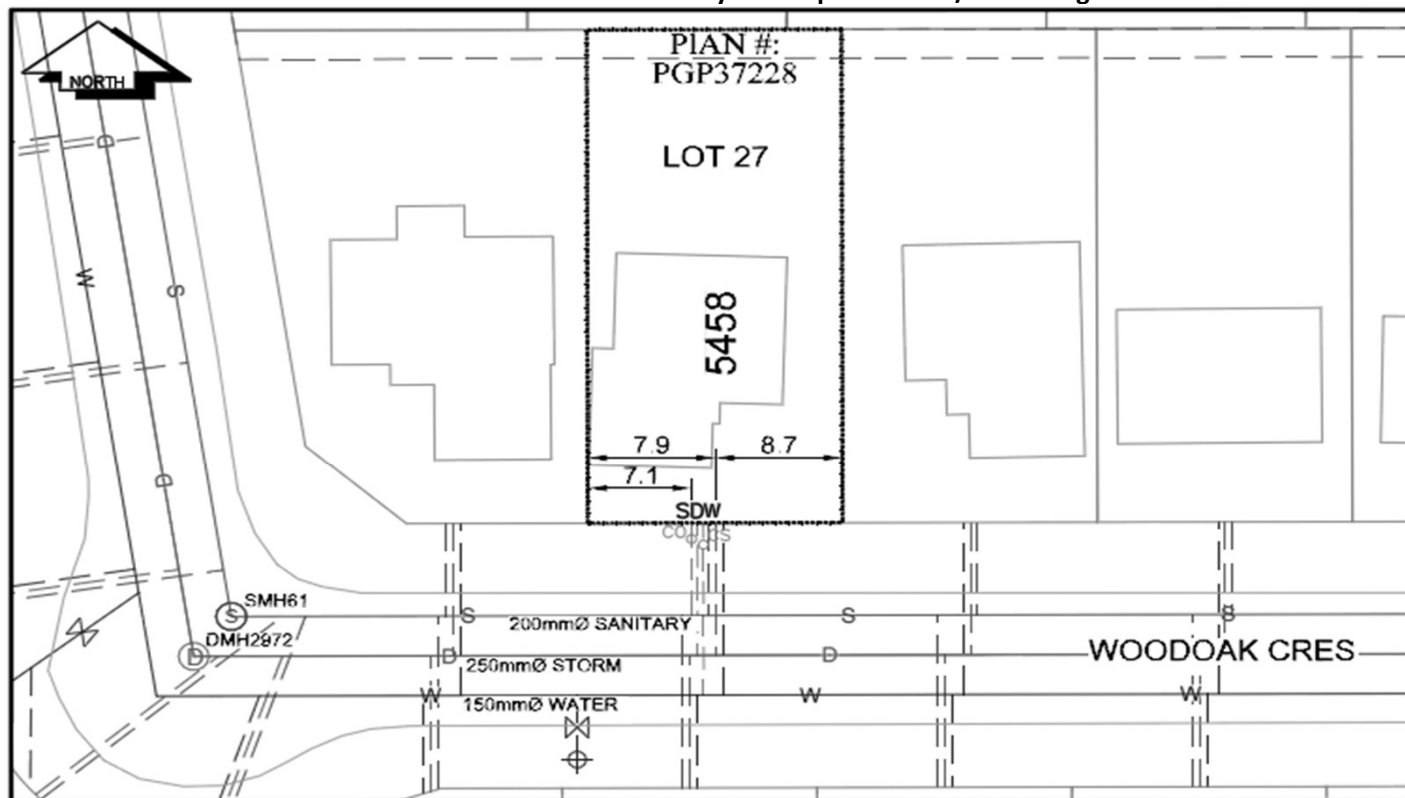

CS ^o CURB STOP	--- WATER SERVICE	--- STORM SERVICE
CO ^o CLEAN OUT	--- SANITARY SERVICE	--- GAS
⊗ WATER VALVE	⊗ FIRE HYDRANT	--- ENCUMBRANCE

NOT TO SCALE