


**Lot Servicing**

6541 BURKITT RD  
**Lot: 6, Plan: PGP40498, DL: 4048**

PID: 023561190

SERVICE	SIZE	MATERIAL	INSTALLED DATE	LOCATION	DETAILS
WATER	20MM	CU		10.0M S OF N PL; S/O 6.5M E AND 1.0M N OF SE CORNER GARAGE	
SANITARY	100MM	PVC		9.50M N OF S PL; C/O 5.4M E AND 1.0M S OF SE CORNER GARAGE	CLEANOUT Y
STORM	100MM	PVC	10-Oct-2007	SERVICE IS RIGHT AT SE COR PL RUNS INTO BC TEL KIOSK	CONNECTION # 28704

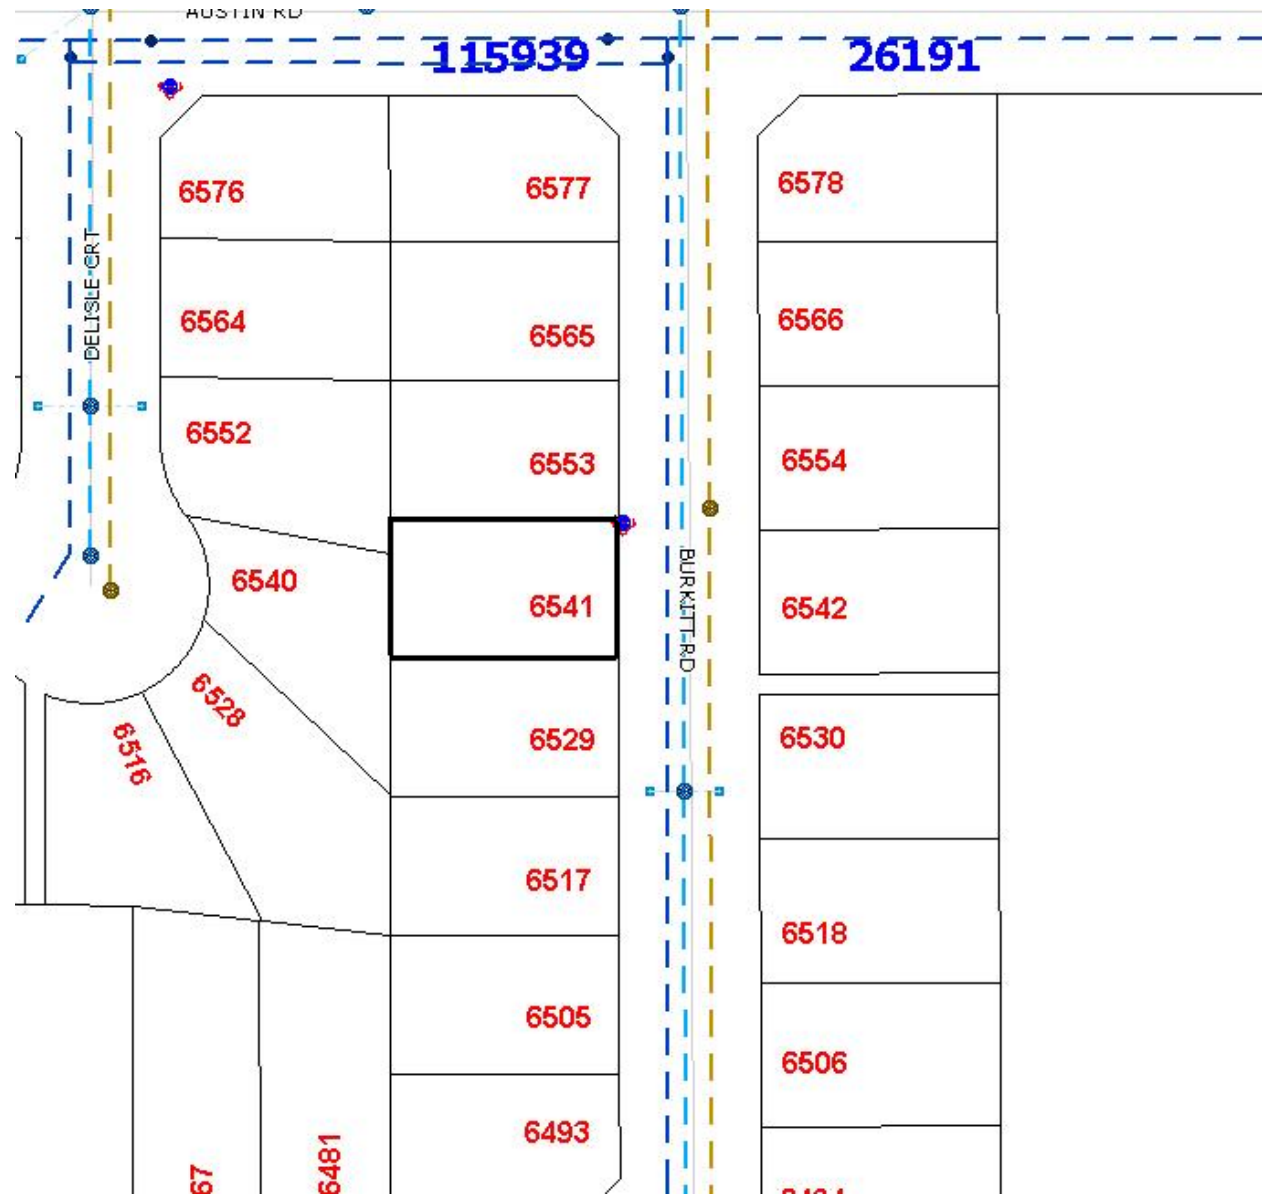

Accuracy not guaranteed unless confirmed by site inspection and/or investigation.  
Connection location between main and property line only.