



City of Prince George History Sheet

PID:	023656425
SD/MU:	
WO:	

Civic Address: 5917 Vanhill Rd
5952 5988 Gauthier Rd

Legal Description: Lot: 1 District Lot: 1592 Plan: PGP40836


Service Type	Diameter (mm)	Material	Invert Elev at main (m)	Invert Elev at property line (m)	Invert Depth at service end (m)	Distance into property (m)	Installation Date
Sanitary (S1)	150mm	PVC	-	-	-	-	December 1980
Sanitary (S2)	150mm	PVC	-	-	3.00	-	December 1980
Sanitary (S3)	100mm	PVC	727.32	-	-	-	December 1980
Water (W1)	150mm	PVC	-	-	-	-	December 1980
Water (W2)	50mm	Copper	-	-	-	-	December 1980
Storm	N/A	N/A	-	-	-	-	

Service Connection Location	Sanitary (m)	Storm (m)
150mm Sanitary connected to San MH4603	-	
150mm Sanitary service connected to PW128		
100mm Sanitary connected to onsite San MH		

Power	Size	Communications	Size	Cable	Size	Gas	Size
BC Hydro	-	Telus	-	Shaw	-	FortisBC	-
Overhead Service		Overhead Service		Overhead Service			

Installed by:	Survey Date:	-
Comments: Water and sanitary services to service station and mobile home park confirmed November 2018.		

NOT TO SCALE The information contained herein is for internal use only.
Not to be relied on unless confirmed by site inspection and/or investigation.

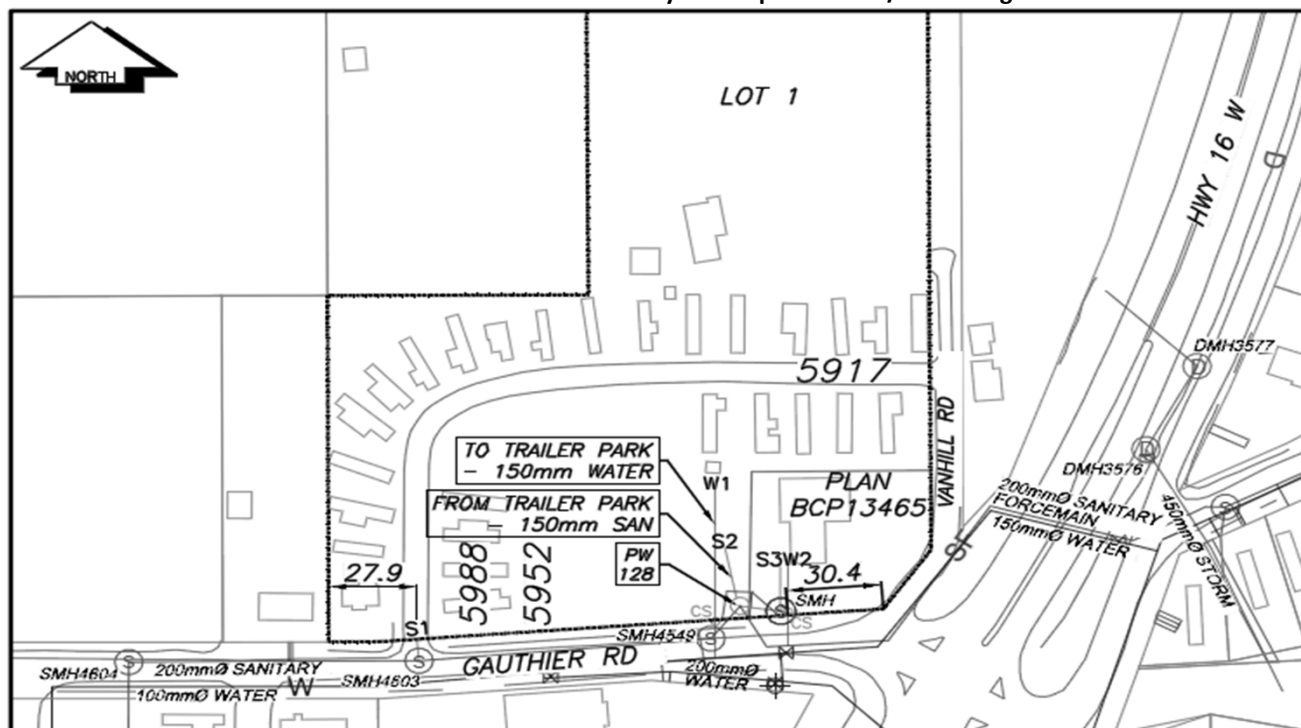

CS° CURB STOP	W WATER SERVICE	○ STORM SERVICE
CO° CLEAN OUT	- - - - - SANITARY SERVICE	- G GAS
⊗ WATER VALVE	⊕ FIRE HYDRANT	- - - - - ENCUMBRANCE

NOT TO SCALE