



City of Prince George History Sheet

PID:	023695421
MU:	100508/101184
WO:	24260/27261
	64419/64420

Civic Address: 6895, 6885 Domano Blvd

Legal Description: Lot: 2 District Lot: 754 Plan: PGP40938

qsave

Service Type	Diameter (mm)	Material	Invert Elev at main (m)	Invert Elev at property line (m)	Invert Elev at service end (m)	Distance into property (m)	Installation Date
Sanitary (6885)	100mm	PVC	-	-	-	-	June 2006
Sanitary (6895)	100mm	PVC	-	-	-	-	July 2012
Water (6885)	25mm	Copper	-	-	-	-	June 2006
Water (6895)	20mm	Copper	-	-	-	-	July 2012
Storm	N/A	N/A	-	-	-	-	


Service Connection Location				Sanitary (m)	Storm (m)
Distance from downstream San MH	4266	towards upstream San MH	4209	53.30	
Distance from downstream San MH	4266	towards upstream San MH	4209	52.30	

Power	Size	Communications	Size	Cable	Size	Gas	Size
BC Hydro	-	Telus	-	Shaw	-	FortisBC	-
Overhead Service		Overhead Service		Overhead Service			

Installed by: City of Prince George forces Survey Date: -

Comments:

NOT TO SCALE The information contained herein is for internal use only.
Not to be relied on unless confirmed by site inspection and/or investigation.

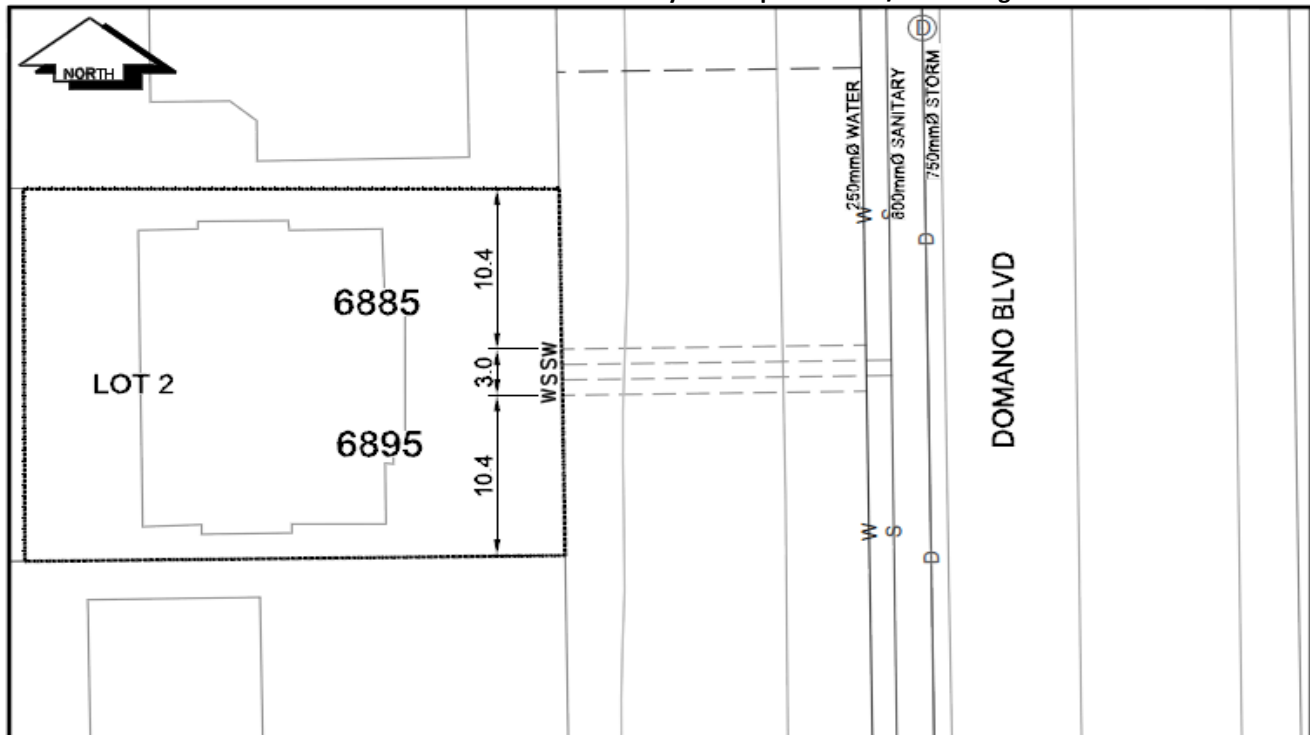

CS CURB STOP	--- WATER SERVICE	--- STORM SERVICE
CO CLEAN OUT	--- SANITARY SERVICE	--- GAS
⊗ WATER VALVE	⊗ FIRE HYDRANT	--- ENCUMBRANCE

NOT TO SCALE