



PID	Civic Address	Lot	Block	Plan	DL	Free Legal
023836172	2942 QUEENSWAY	PCL B	25	727	933	(PL43382)

Accuracy Not Guaranteed Unless Confirmed By Site Inspection and/or Investigation.
Sketch is Oriented North (NTS)

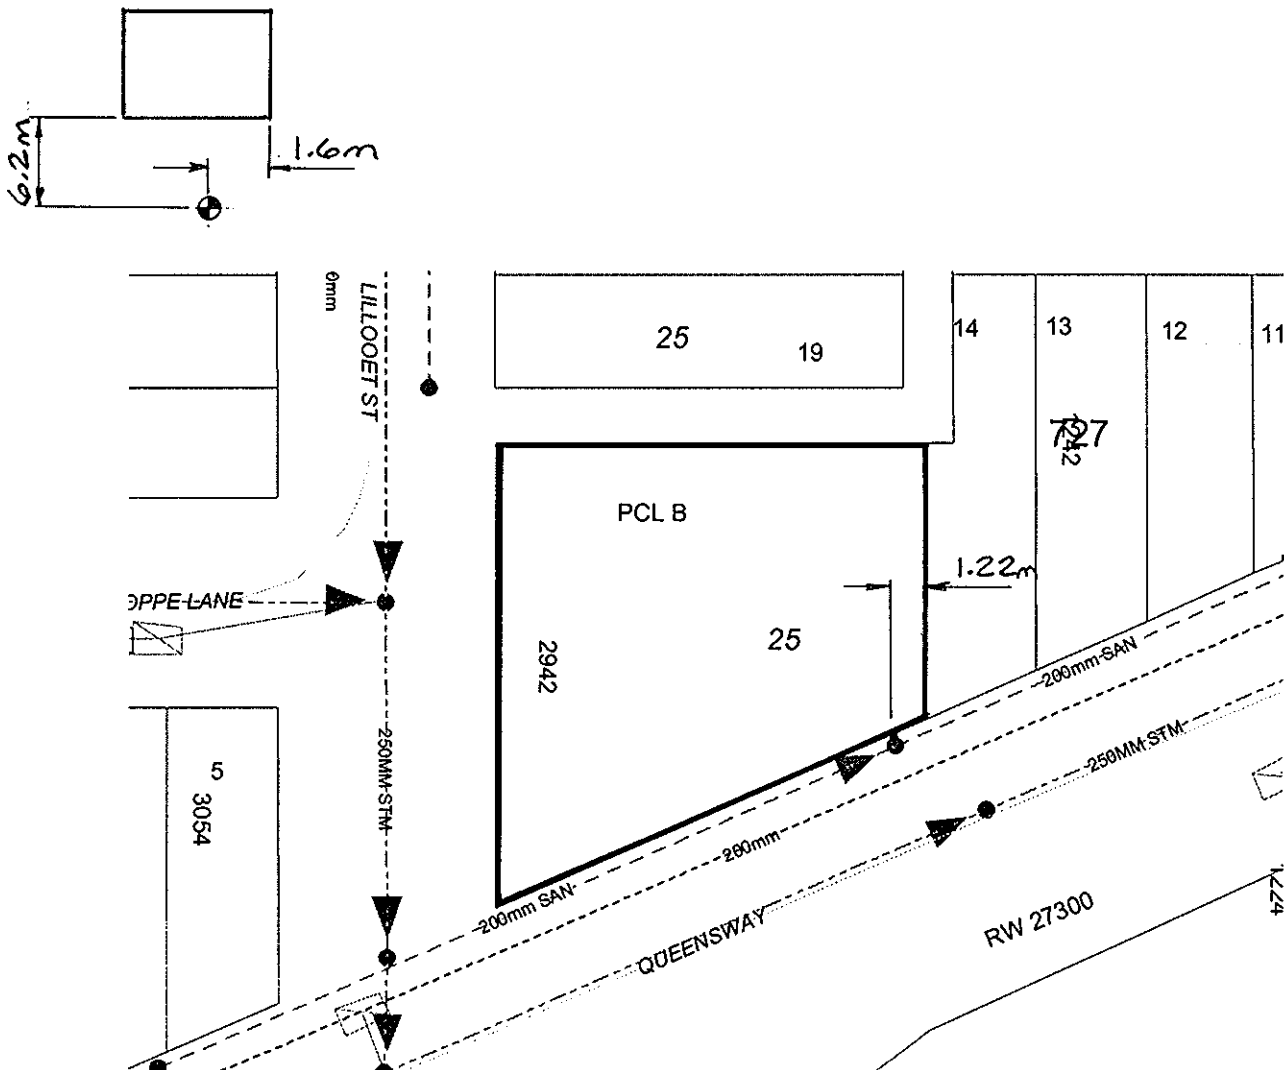

Sewer

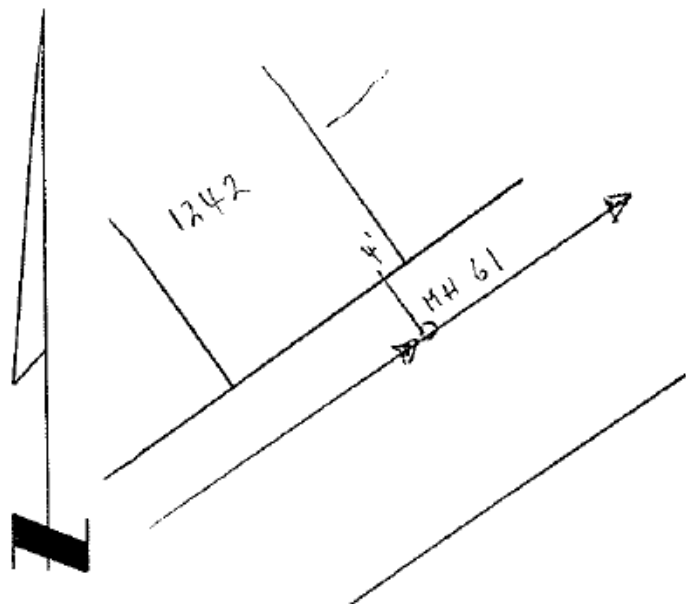

Water

