

City of Prince George
HISTORY SHEET

SHEET NUMBER

Roll Number 02387 5917

Legal: LOT'S 3 BLOCK D.L. 635 PLAN 41619

Address: 7582 GISLOME ROAD

Sanitary Connection: # SIZE 150 mm MATERIAL P.V.C. INV. CONNECTED

Water Connection # BID SIZE 20 mm MATERIAL METER CONNECTED

Storm Connection: # SIZE MATERIAL INV. CONNECTED

Cash Receipt No's: WATER ? SANITARY ? STORM

CURB FROM PROPERTY LINE PAVEMENT WIDTH

B.C. HYDRO O/H UNDERGROUND CONNECTION


B.C. TELEPHONE O/H UNDERGROUND CONNECTION

INLAND GAS AS SHOWN

Information Sheets:

Comments:

THE INFORMATION CONTAINED HEREIN IS FOR INTERNAL USE ONLY.
NOT TO BE RELIED UPON UNLESS CONFIRMED BY SITE INSPECTION AND/OR INVESTIGATION

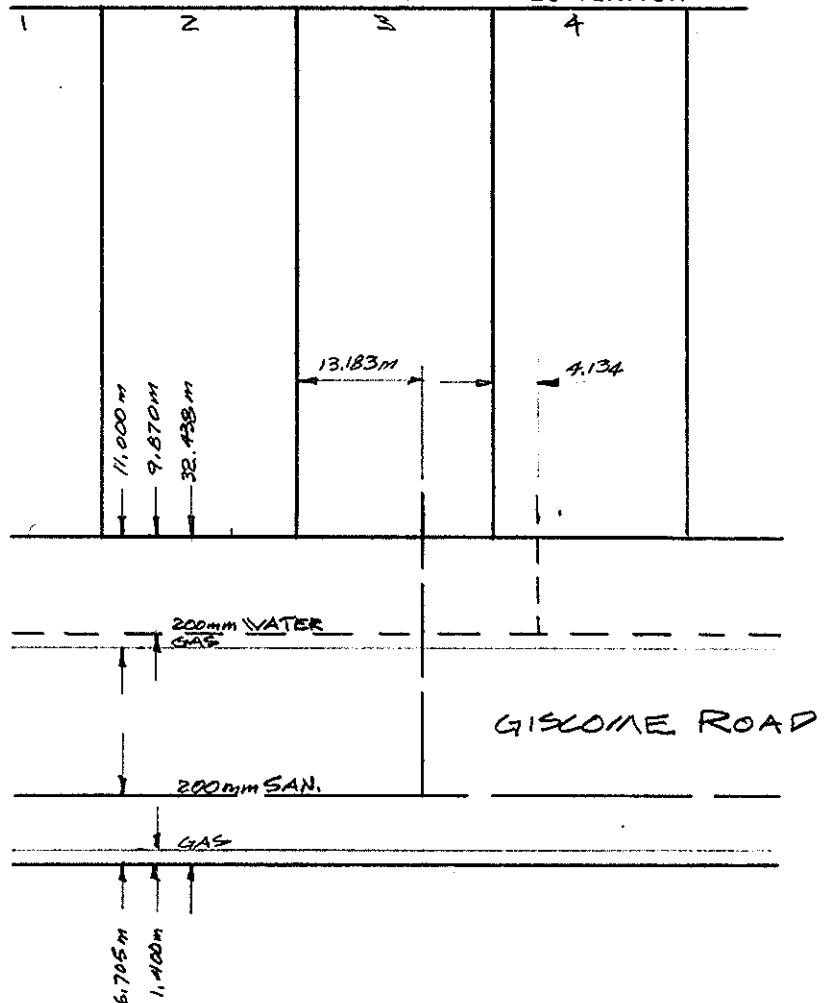

083875917


REPORT TO RECORDS

WATER SERVICE INFORMATION

Lot No. _____ Block _____ D.L. _____

Address 7582 GISCOMB RD.Size of Connection ☐ 1/2" ☒ 3/4" ☐ Other _____Type of Connection ☒ Copper ☐ IronThaw Wire ☒ Yes ☐ No

LOCATION SKETCH

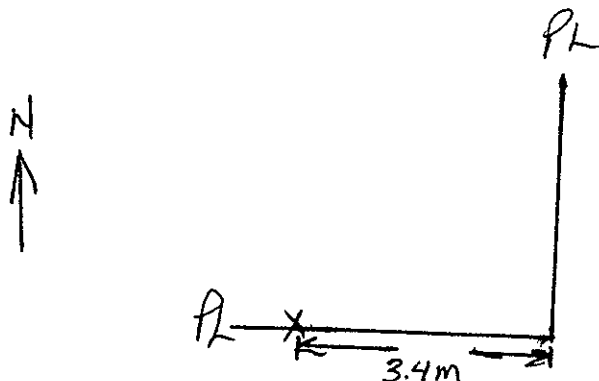Field Location By L. Panko- Date May 14/01

Checked by: _____

CITY PUBLIC WORKS DEPT 023875417-5
REPORT TO RECORDS

SEWER SERVICE INFORMATION

Lot No. _____ Block _____ D.L. _____


Address 7582 GISCOMB RD

Size of Connection ☒ 100mm ☐ 150mm ☐ 200mm ☐ Other _____

Type of Connection ☐ Transit ☒ PVC ☐ Other _____

Type of Cap ☐ Transit ☒ Cast Iron

LOCATION SKETCH

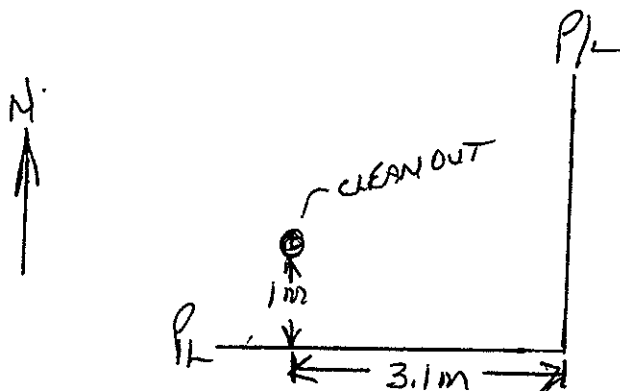

Field Location By L. Pinks Date May 14/01

Checked by Foreman - Sewer Division _____