
City of Prince George

SHEET NUMBER 3 of 25		ROLL NUMBER 023 898 963
Legal: LOT 3	D.L. 4047	PLAN PGP41662
Address: 6357 DRIFTWOOD PL	reactive desired	
Sanitary Connection: # SIZE: 100mm#	MATERIAL: PVC INV.	728.14m CONNECTED
Water Connection: # FROM MAIN: 19mm# C	OPPER MET	ER
Storm Connection: # SIZE 100mm#	MATERIAL PVC INV.	728.15m CONNECTED
Cash Receipt No's: WATER	SANITARY	STORM
CURB FROM PROPERTY LINE 5.0m		PAVEMENT WIDTH 10.0m
B.C. HYDRO 1m- 5m FROM PROPERTY LINE	U/G CONNECTION	✓
B.C. TELEPHONE 1m - 5m FROM PROPERTY LINE	U/G CONNECTION	<u> </u>
B.C. GAS UNDERGROUND		
Information Sheets: REF. DWGS. L&M ENGINEERING	LTD. JOB. 1088-04-03 DWGS.	
Comments:		

THE INFORMATION CONTAINED HEREIN IS FOR INTERNAL USE ONLY.
NOT TO BE RELIED UPON UNLESS CONFIRMED BY THE SITE INSPECTION AND/OR INVESTIGATION

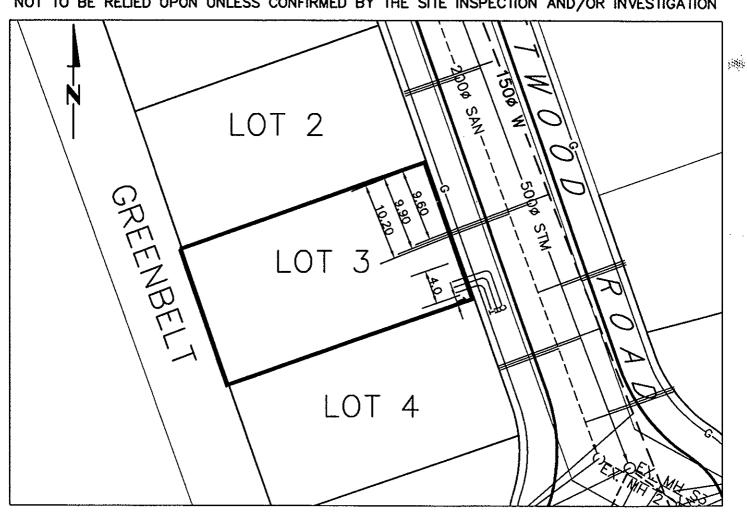

anankir