

City of Prince George
HISTORY SHEET

SHEET NUMBER 11 of 25

ROLL NUMBER 023 899 042

Legal: LOT 11

D.L. 4047 / D.L. 4028

PLAN PGP41662

Address: 8368 DRIFTWOOD PL

Sanitary Connection: # SIZE: 100mm# MATERIAL: PVC INV. 727.58m CONNECTED

Water Connection: # FROM MAIN: 19mm# COPPER METER

Storm Connection: # SIZE 100mm# MATERIAL PVC INV. 727.57m CONNECTED

Cash Receipt No's: WATER SANITARY STORM

CURB FROM PROPERTY LINE 5.0m PAVEMENT WIDTH 10.0m

B.C. HYDRO 1m - 5m FROM PROPERTY LINE U/G CONNECTION ✓


B.C. TELEPHONE 1m - 5m FROM PROPERTY LINE U/G CONNECTION ✓

B.C. GAS UNDERGROUND

Information Sheets: REF. DWGS. L&M ENGINEERING LTD. JOB. 1088-04-03 DWGS.

Comments:


THE INFORMATION CONTAINED HEREIN IS FOR INTERNAL USE ONLY.
NOT TO BE RELIED UPON UNLESS CONFIRMED BY THE SITE INSPECTION AND/OR INVESTIGATION

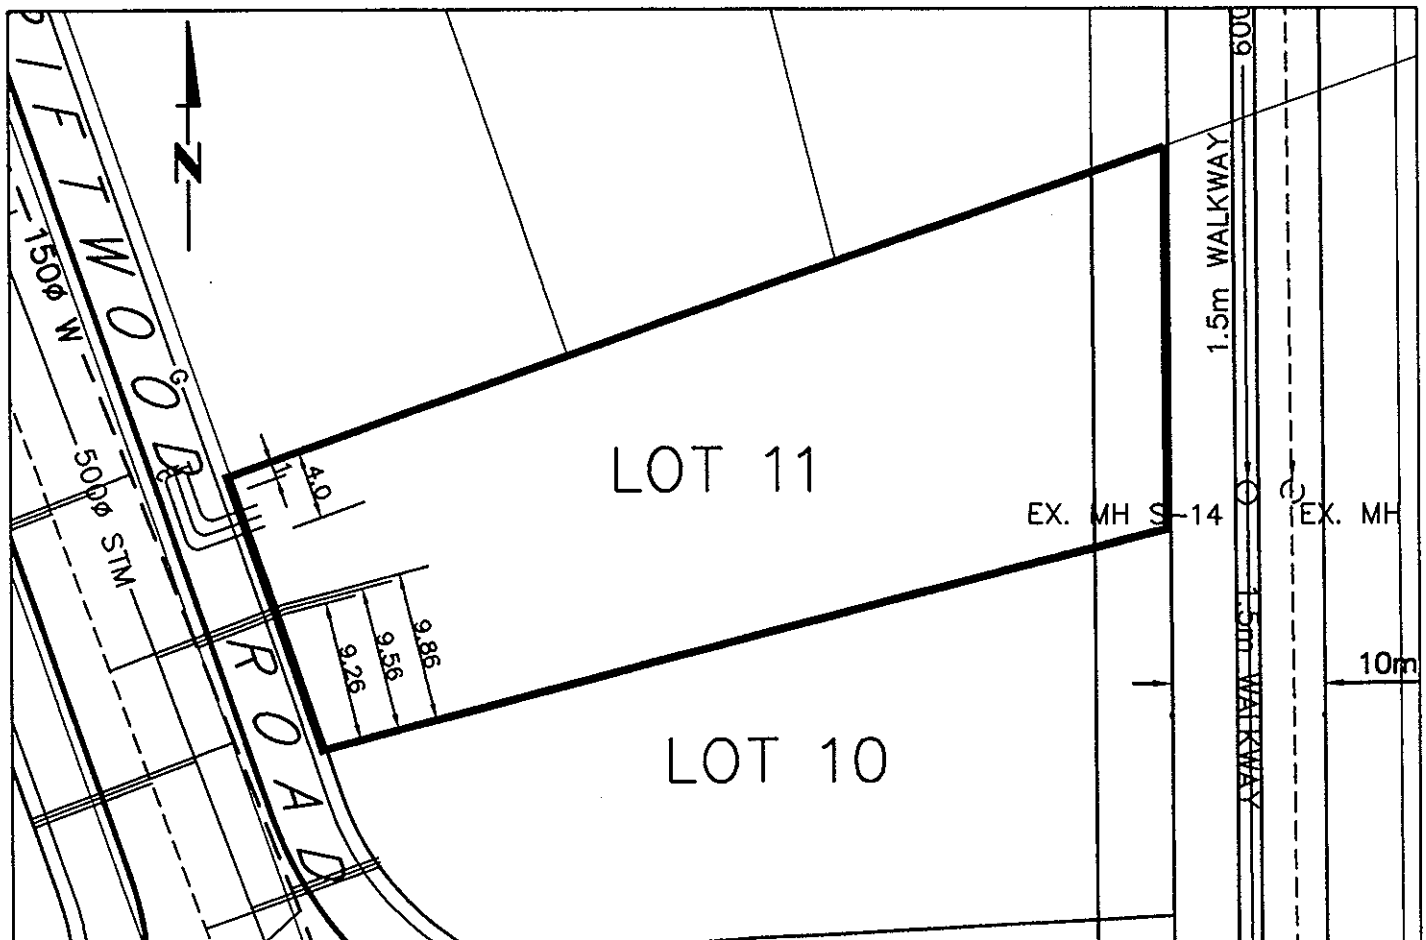

UTILITY OPERATIONS CONNECTION INSPECTION FORM

Property Address: 6368 DRIFTWOOD AVE Lot #

Native Soil: SAND Backfill Material: SAND

Diagram of Location: Water ☒ Sanitary ☒ Storm ☐ See over for diagrams **76205** 

WATER INSPECTION

City Pipe Material: 20mm COPPER Private Pipe Material: 25mm PLASTIC

Fittings: Size: 20mm mm Thaw Wire: OK ☒

Comments: S.P. O.K.

Inspected by City Building Inspector: [Signature] Date: SEPT. 30/04

Inspected By: L. Linko + GUS P. Date: SEPT 30/04

LOCATES: 

STORM INSPECTION

City Pipe Material: P.V.C. Private Pipe Material: P.V.C.

Fittings: Size: 100 mm

Comments:

Inspected by City Building Inspector: [Signature] Date: SEPT. 30/04

Identified By: L. Linko + GUS P. Date: SEPT 30/04

LOCATES: 

SANITARY IDENTIFICATION 1 (At Property Line)

City Pipe Material: P.V.C. Private Pipe Material: P.V.C.

Dye Test 1: Pass ☒ Fail ☐ Fittings: Size: 100 mm

Comments:

Steel Cap on Cleanout? ☒ Yes ☐ No

Inspected by City Building Inspector: [Signature] Date: SEPT 30/04

Identified by: L. Linko + GUS P. Date: SEPT 30/04

SANITARY IDENTIFICATION 2 (Final)

Dye Test 2: Pass ☐ Fail ☐

Comments:

Steel Cap on Cleanout? ☐ Yes ☐ No

Inspected by City Building Inspector: Date:

Identified By: Date:

Note: Sanitary Inspection 1 at property line is to be inspected and approved to reduce the risk of a cross connection. The Final Sanitary Inspection is required before occupancy to ensure a cross connection has not occurred between the property line and the building.


UTILITY OPERATIONS

9.3

Water Service Information

Size of Connection ☐ 1/2" ☒ 3/4" ☐ Other Type of Connection ☒ Copper ☐ Iron
 Thaw Wire ☒ Yes ☐ No


Location Sketch

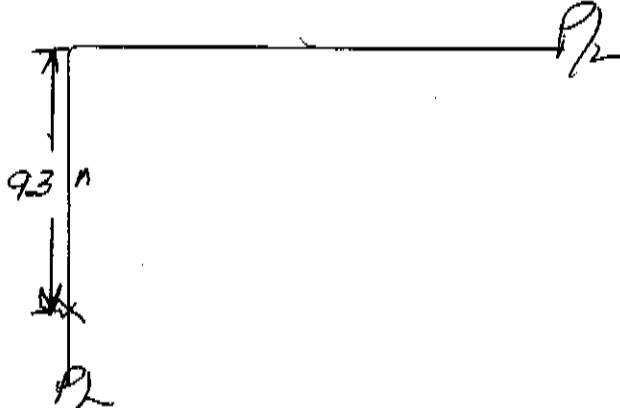

Storm Connection

Size of Connection ☒ 100mm ☐ 150mm ☐ Other ☐ 200mm ☐ Other
 Type of Connection ☐ Transite ☒ PVC ☐ Other
 Type of Cap ☐ Transite ☒ Cast Iron

Location Sketch

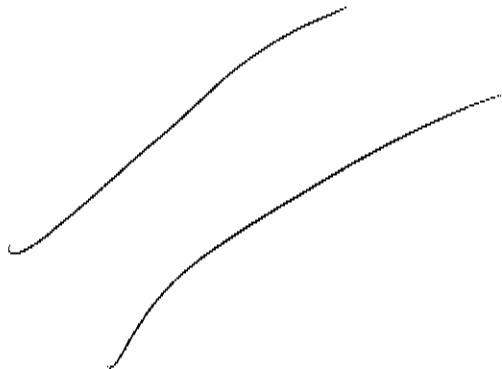

Sewer Connection

Size of Connection ☒ 100mm ☐ 150mm ☐ Other ☐ 200mm ☐ Other
 Type of Connection ☐ Transite ☒ PVC ☐ Other
 Type of Cap ☐ Transite ☒ Cast Iron

9.8

Location Sketch

