
City of Prince George

SHEET NUMBER 22 of 25		ROLL NUMBER	023-899-158
Legal: LOT 22	D.L. 402	28	PLAN PGP41662
Address: 6252 DAWSON ROAD			
Sanitary Connection: # SIZE: 100mm# MATERIA	AL: PVC IN	V. 728.82 m	CONNECTED
Water Connection: # FROM MAIN: 19mm# COPPER	МЕ	TER	
Storm Connection: # SIZE 100mm# MATERIA	AL PVC IN	v. 728.82m	CONNECTED
Cash Receipt No's: WATER	SANITARY	ST	ORM
CURB FROM PROPERTY LINE 5.0m		PAVEMENT V	MDTH 10.0m
B.C. HYDRO 1m - 5m FROM PROPERTY LINE	U/G CONNECTION		
B.C. TELEPHONE 1m - 5m FROM PROPERTY LINE	U/G CONNECTION		
B.C. GAS UNDERGROUND			
Information Sheets: REF. DWGS. LAM ENGINEERING LTD. JOB. 1088\-04-03 DWGS.			
Comments:			

THE INFORMATION CONTAINED HEREIN IS FOR INTERNAL USE ONLY.

NOT TO BE RELIED UPON UNLESS CONFIRMED BY THE SITE INSPECTION AND/OR INVESTIGATION

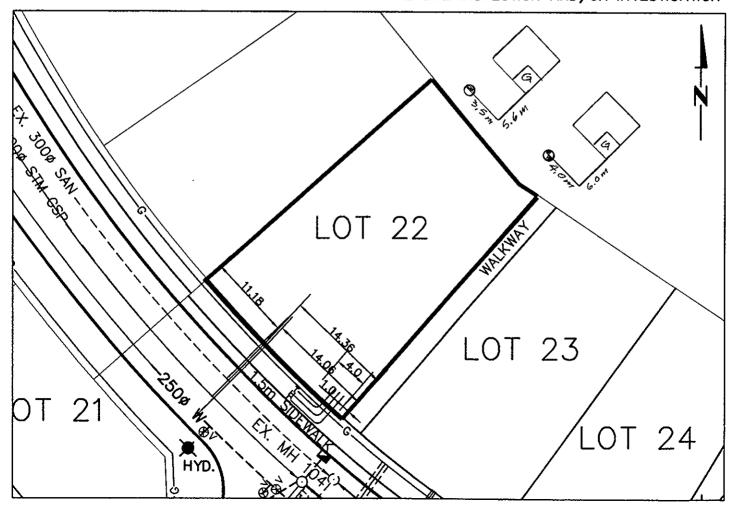

3999