

# City of Prince George HISTORY SHEET

SHEET NUMBER

ROLL NUMBER

02395/583

Legal: LOT D.L. PLAN

Address: #5961 LELAND ROAD

Sanitary Connection:# SIZE: 100mm  $\phi$  MATERIAL: PVC INV. 737.65 CONNECTED

Water Connection:# FROM MAIN: 19mm  $\phi$  COPPER METER

Storm Connection:# SIZE MATERIAL INV. CONNECTED

Cash Receipt No's: WATER SANITARY STORM

CURB FROM PROPERTY LINE PAVEMENT WIDTH 8.0m

B.C. HYDRO U/G CONNECTION


B.C. TELEPHONE U/G CONNECTION

B.C. GAS

Information Sheets: REF DWGS: L&M ENGINEERING LIMITED - JOB# 1035-10-03 - DWGS S1 TO S5

Comments:

THE INFORMATION CONTAINED HEREIN IS FOR INTERNAL USE ONLY.  
NOT TO BE RELIED UPON UNLESS CONFIRMED BY THE SITE INSPECTION AND/OR INVESTIGATION

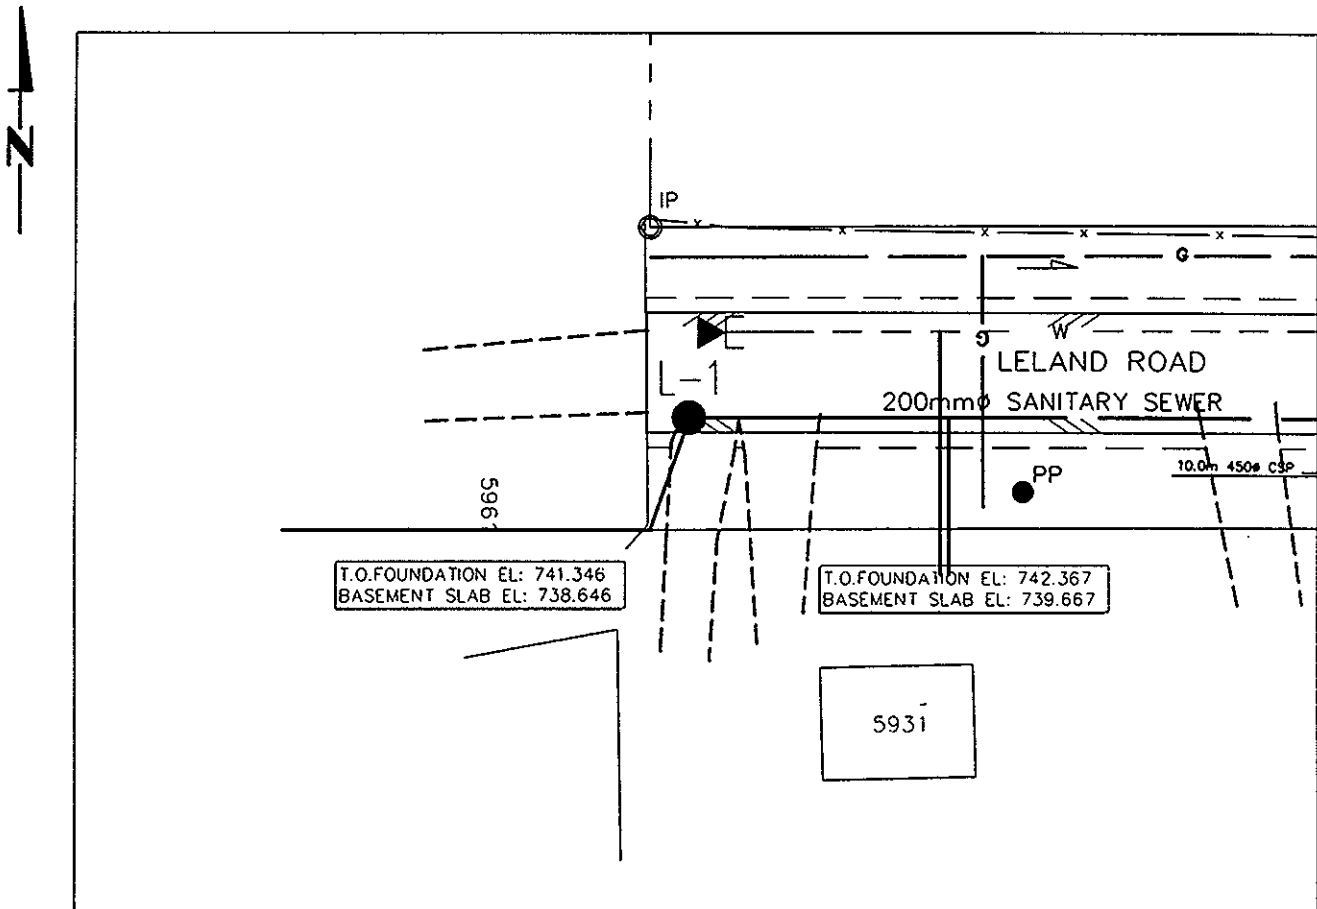

City of Prince George  
HISTORY SHEET

S

SHEET NUMBER

ROLL NUMBER

023951583

Legal: LOT 1

D.L. 1592 & 1593

PLAN PGP41758

Address: #5961 LELAND ROAD

Sanitary Connection:# SIZE: 100mm  $\phi$  MATERIAL: PVC INV. 737.65 CONNECTED

Water Connection:# FROM MAIN: 19mm  $\phi$  COPPER METER

Storm Connection:# SIZE MATERIAL INV. CONNECTED

Cash Receipt No's: WATER SANITARY STORM

CURB FROM PROPERTY LINE

PAVEMENT WIDTH 8.0m

B.C. HYDRO

U/G CONNECTION

B.C. TELEPHONE

U/G CONNECTION

B.C. GAS

Information Sheets: REF DWGS: L&M ENGINEERING LIMITED - JOB# 1035-10-03 - DWGS S1 TO S5

Comments:

THE INFORMATION CONTAINED HEREIN IS FOR INTERNAL USE ONLY.  
NOT TO BE RELIED UPON UNLESS CONFIRMED BY THE SITE INSPECTION AND/OR INVESTIGATION

