
City of Prince George HISTORY SHEET

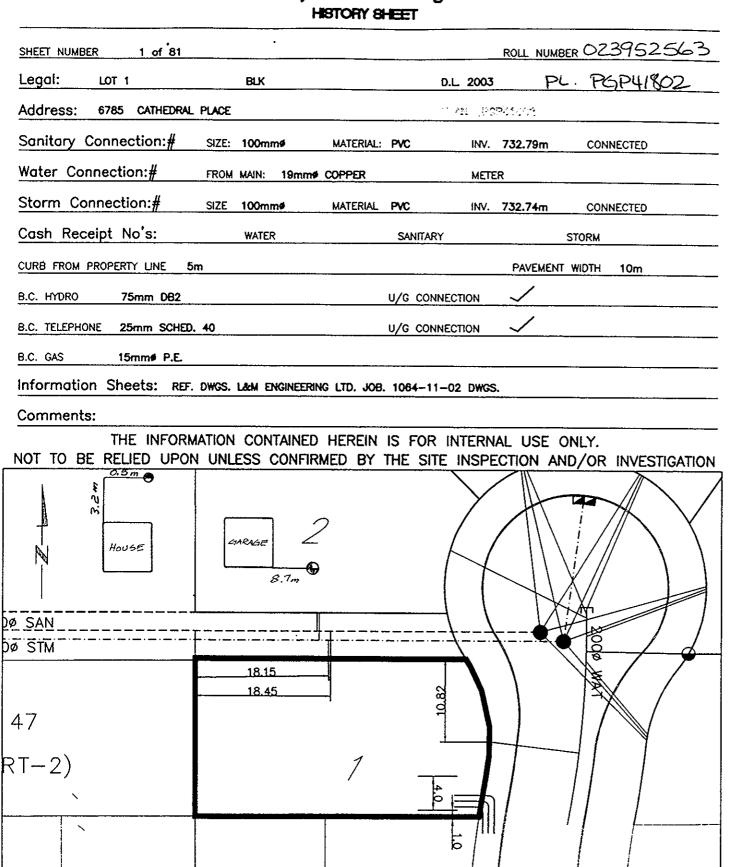

45