

City of Prince George
HISTORY SHEET

SHEET NUMBER 22 of 81

ROLL NUMBER 023952776

Legal: LOT 22

D.L. 2003

PL. PGP41802

Address: 6711 WESTMOUNT DRIVE

Sanitary Connection:# SIZE: 100mm# MATERIAL: PVC INV. 730.73m CONNECTED

Water Connection:# FROM MAIN: 19mm# COPPER METER

Storm Connection:# SIZE 100mm# MATERIAL PVC INV. 732.08m CONNECTED

Cash Receipt No's: WATER SANITARY STORM

CURB FROM PROPERTY LINE 5m PAVEMENT WIDTH 10m

B.C. HYDRO 75mm DB2 U/G CONNECTION ✓

B.C. TELEPHONE 25mm SCHED. 40 U/G CONNECTION ✓

B.C. GAS 15mm# P.E.

Information Sheets: REF. DWGS. L&M ENGINEERING LTD. JOB. 1084-11-02 DWGS.

Comments:

THE INFORMATION CONTAINED HEREIN IS FOR INTERNAL USE ONLY.
NOT TO BE RELIED UPON UNLESS CONFIRMED BY THE SITE INSPECTION AND/OR INVESTIGATION

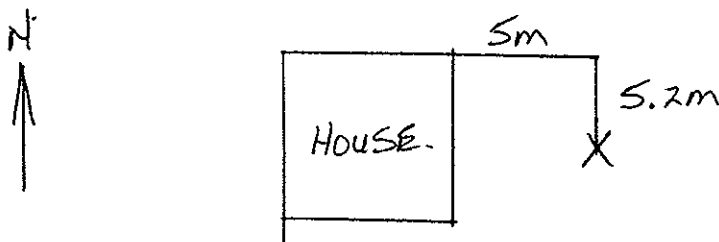


REPORT TO RECORDS

WATER SERVICE INFORMATION

Lot No. 22-2063-41802 Block _____ D.L. _____Address 6711 WESTMOUNT ~~DR~~ CRESSize of Connection ☐ 1/2" ☒ 3/4" ☐ Other _____Type of Connection ☒ Copper ☐ IronThaw Wire ☒ Yes ☐ No

LOCATION SKETCH

Field Location By L. Panko Date May 30/00

Checked by: _____

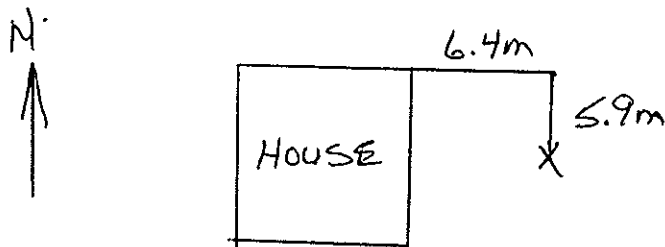
REPORT TO RECORDS

SEWER SERVICE INFORMATION

Lot No. _____ Block _____ D.L. _____

Address 6711 WESTMOUNT CRESSize of Connection ☒ 100mm ☐ 150mm ☐ 200mm ☐ Other _____Type of Connection ☐ Transite ☒ PVC ☐ Other _____Type of Cap ☐ Transite ☐ Cast Iron

LOCATION SKETCH

Field Location By L. Linko Date May 30/00

Checked by Foreman - Sewer Division _____