
SHEET NUMBER 25 of 81	ROLL NUMBER 023952806 D.L. 2003 P.L. PSP41802
Legal: LOT 25	D.L. 2003 PL. PGP4/802
Address: 6676 WESTMOUNT DRIVE	64 (1) propostsom
Sanitary Connection:# SIZE: 100mm≠ MAT	ERIAL: PVC INV. 729.37m CONNECTED
Water Connection:# FROM MAIN: 19mm≠ COPP	PER METER
Storm Connection:# SIZE 100mm# MAT	TERIAL PVC INV. 730.53m CONNECTED
Cash Receipt No's: WATER	SANITARY STORM
CURB FROM PROPERTY LINE 5m	PAVEMENT WIDTH 10m
B.C. HYDRO 75mm DB2	U/G CONNECTION ✓
B.C. TELEPHONE 25mm SCHED. 40	U/G CONNECTION ✓
B.C. GAS 15mm# P.E.	
Information Sheets: REF. DWGS. LAM ENGINEERING LTD. JOB. 1064-11-02 DWGS.	
Comments:	

THE INFORMATION CONTAINED HEREIN IS FOR INTERNAL USE ONLY.
NOT TO BE RELIED UPON UNLESS CONFIRMED BY THE SITE INSPECTION AND/OR INVESTIGATION

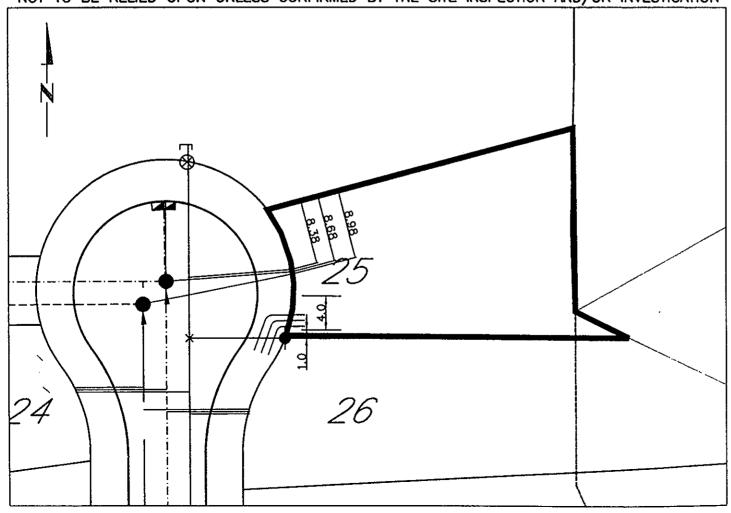

25168°