

City of Prince George
HISTORY SHEET

SHEET NUMBER 29 of 81

ROLL NUMBER 023952849

Legal: LOT 29

D.L. 2003

P&P 41802

Address: 6724 WESTMOUNT DRIVE

Sanitary Connection:# SIZE: 100mm ϕ MATERIAL: PVC INV. 731.26m CONNECTED ☒

Water Connection:# FROM MAIN: 19mm ϕ COPPER METER

Storm Connection:# SIZE 100mm ϕ MATERIAL PVC INV. 733.690 CONNECTED ☒

Cash Receipt No's: WATER SANITARY STORM

CURB FROM PROPERTY LINE 5m PAVEMENT WIDTH 10m

B.C. HYDRO 75mm DB2 U/G CONNECTION ☒

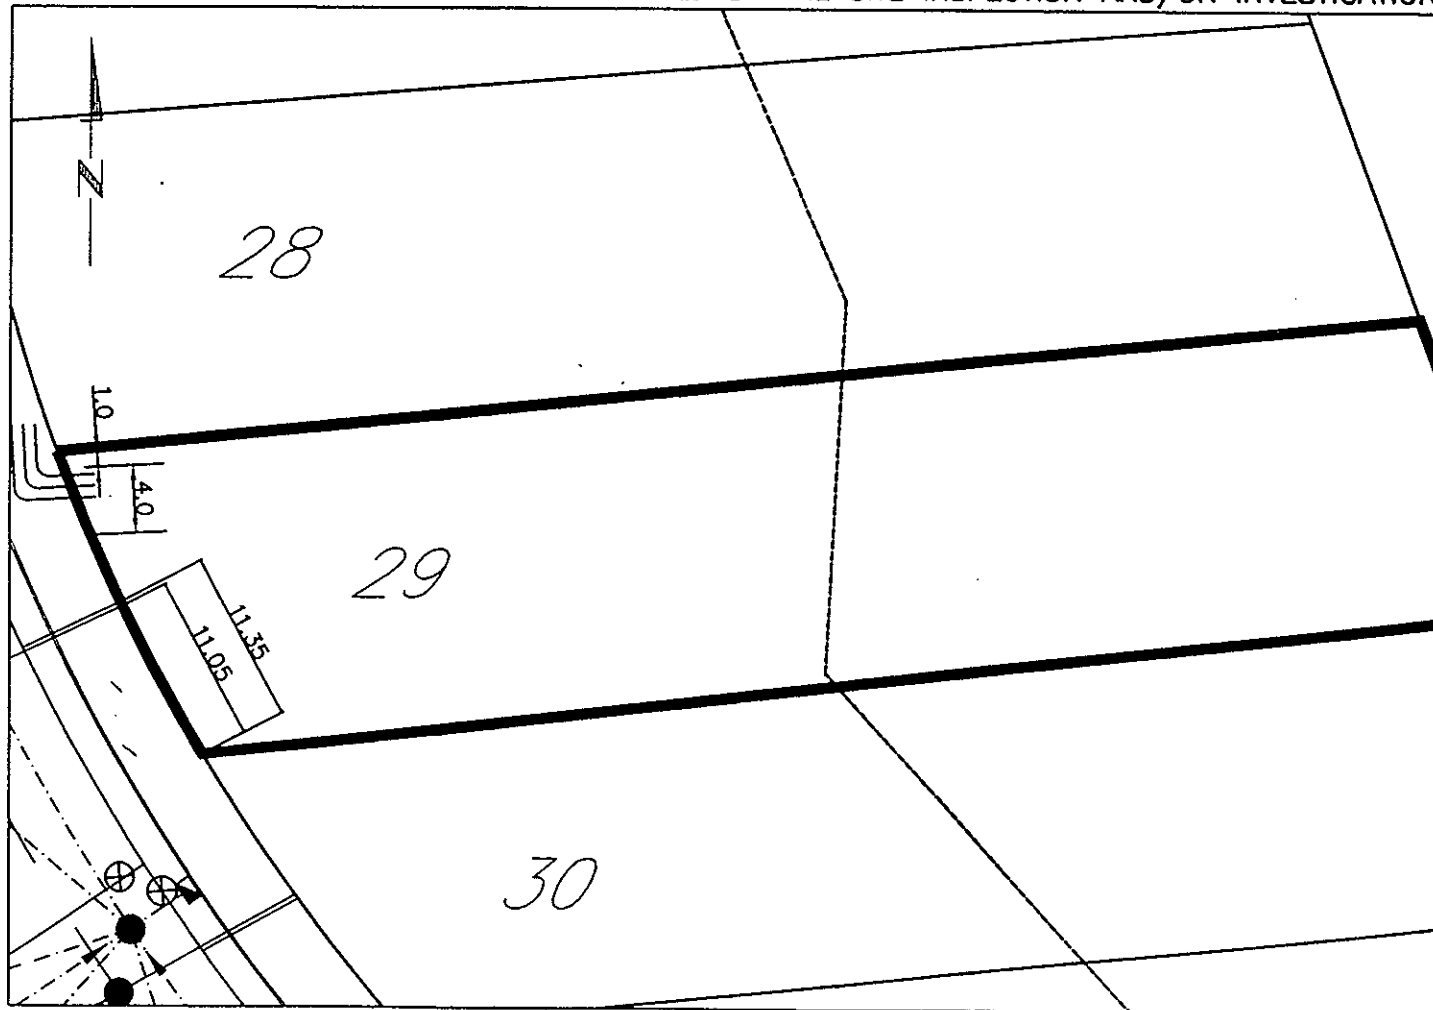
B.C. TELEPHONE 25mm SCHED. 40 U/G CONNECTION ☒

B.C. GAS 15mm ϕ P.E.

Information Sheets: REF. DWGS. L&M ENGINEERING LTD. JOB. 1064-11-02 DWGS.

Comments:

THE INFORMATION CONTAINED HEREIN IS FOR INTERNAL USE ONLY.
NOT TO BE RELIED UPON UNLESS CONFIRMED BY THE SITE INSPECTION AND/OR INVESTIGATION



0239528-19

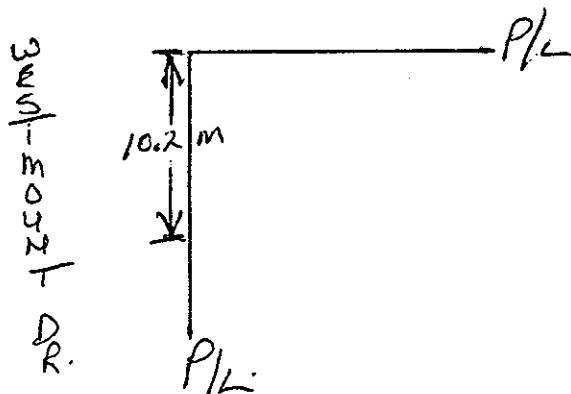
REPORT TO RECORDS

WATER SERVICE INFORMATION

Lot No. _____ Block _____ D.L. _____

Address 6724 WESTMOUNT DR.Size of Connection ☐ 1/2" ☒ 3/4" ☐ Other _____Type of Connection ☒ Copper ☐ IronThaw Wire ☒ Yes ☐ No

LOCATION SKETCH

Field Location By L. Linko Date April 27/01

Checked by: _____

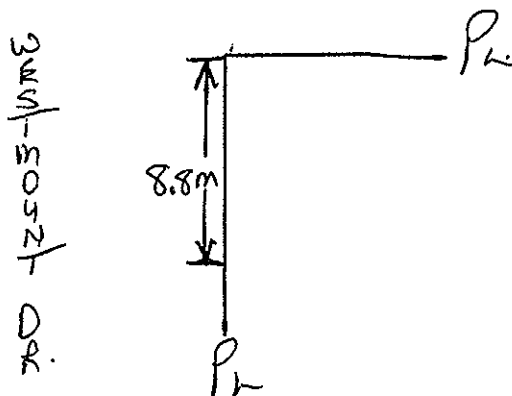
REPORT TO RECORDS

SEWER SERVICE INFORMATION

Lot No. _____ Block _____ D.L. _____

Address 6724 WESTMOUNT DR.Size of Connection ☒ 100mm ☐ 150mm ☐ 200mm ☐ Other _____Type of Connection ☐ Transite ☒ PVC ☐ Other _____Type of Cap ☐ Transite ☒ Cast Iron

LOCATION SKETCH

Field Location By L. Pinks Date April 27/01

Checked by Foreman - Sewer Division _____