

HISTORY SHEET

SHEET NUMBER **31 of 81**

ROLL NUMBER 023952865

Legal: LOT 31

D.L. 2003

PL. PGP41802

Address: 8748 WESTMOUNT DRIVE

Sanitary Connection: # SIZE: 100mm# MATERIAL: PVC INV. 733.13m CONNECTED ✓

Water Connection: # FROM MAIN: 19mm# COPPER METER

Storm Connection: # SIZE 100mm ϕ MATERIAL P.V.C. INV. 734.440 CONNECTED ☒

Cash Receipt No's:	WATER	SANITARY	STORM
--------------------	-------	----------	-------

CURB FROM PROPERTY LINE 5m PAVEMENT WIDTH 10m

B.C. HYDRO	75mm DB2	U/G CONNECTION	✓
------------	----------	----------------	---

B.C. TELEPHONE 25mm SCHED. 40 U/G CONNECTION ☒

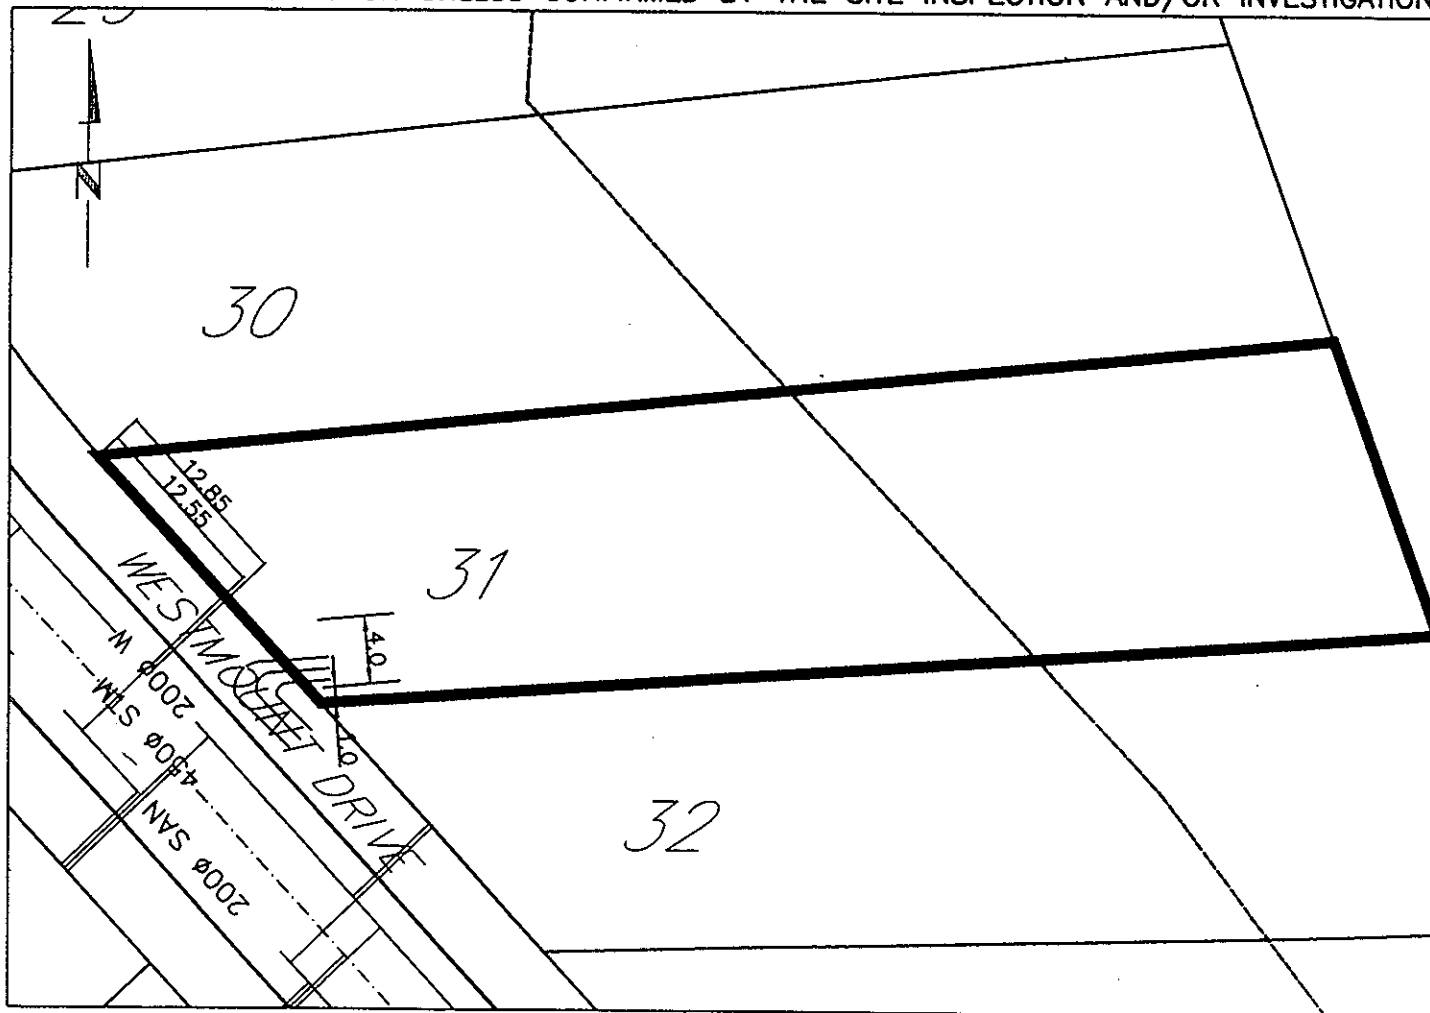
B.C. GAS 15mm P.E.

Information Sheets: REF. DWGS. L&M ENGINEERING LTD. JOB. 1064-11-02 DWGS.

Comments:

THE INFORMATION CONTAINED HEREIN IS FOR INTERNAL USE ONLY.

NOT TO BE RELIED UPON UNLESS CONFIRMED BY THE SITE INSPECTION AND/OR INVESTIGATION



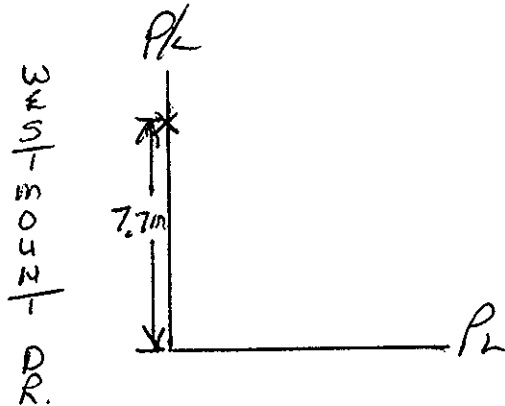
REPORT TO RECORDS

WATER SERVICE INFORMATION

Lot No. _____ Block _____ D.L. _____

Address 6748 WESTMOUNT DR.Size of Connection ☐ 1/2" ☒ 3/4" ☐ Other _____Type of Connection ☒ Copper ☐ IronThaw Wire ☒ Yes ☐ No

LOCATION SKETCH

Field Location By L. Pardo. Date Nov. 20/00

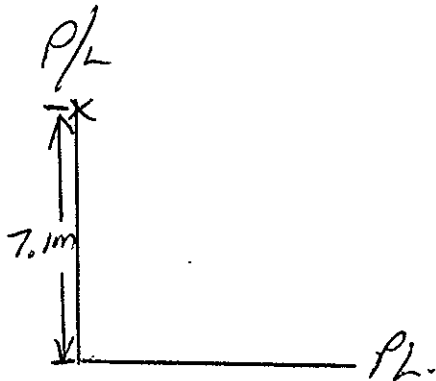
Checked by: _____

REPORT TO RECORDS

SEWER SERVICE INFORMATION

31-2003-41802

Lot No. _____ Block _____ D.L. _____

Address 6748 WESTMOUNT DR.Size of Connection ☒ 100mm ☐ 150mm ☐ 200mm ☐ Other _____Type of Connection ☐ Transit ☒ PVC ☐ Other _____Type of Cap ☐ Transit ☒ Cast Iron**LOCATION SKETCH**Field Location By L. Panko Date Nov. 20/00

Checked by Foreman - Sewer Division _____