

City of Prince George  
HISTORY SHEET

SHEET NUMBER 41 of 81

ROLL NUMBER 023 952962

Legal: LOT 41

D.L. 1605

PLAN PGP41802

Address: 6856 WESTMOUNT DRIVE

Sanitary Connection:# SIZE: 100mm $\phi$  MATERIAL: PVC INV. 737.47m CONNECTED ☒

Water Connection:# FROM MAIN: 19mm $\phi$  COPPER METER

Storm Connection:# SIZE 100mm $\phi$  MATERIAL P.V.C. INV. 738.770m CONNECTED ☒

Cash Receipt No's: WATER SANITARY STORM

CURB FROM PROPERTY LINE 5m PAVEMENT WIDTH 10m

B.C. HYDRO 75mm DB2 U/G CONNECTION

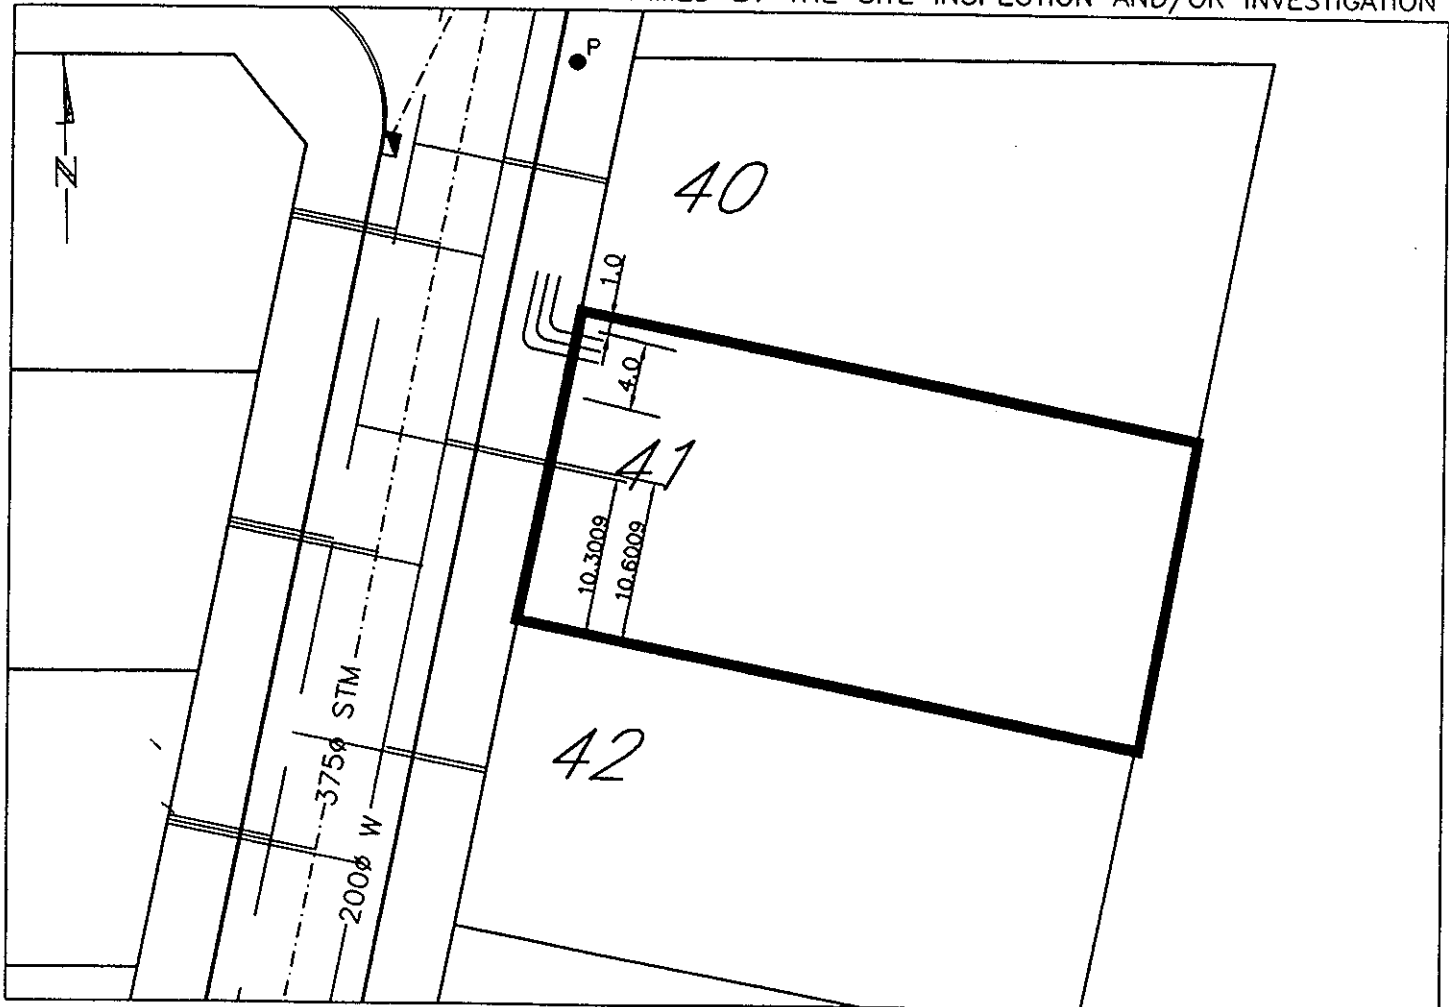
B.C. TELEPHONE 25mm SCHED. 40 U/G CONNECTION

B.C. GAS 15mm $\phi$  P.E.

Information Sheets: REF. DWGS. L&M ENGINEERING LTD. JOB. 1064-11-02 DWGS.

Comments:

THE INFORMATION CONTAINED HEREIN IS FOR INTERNAL USE ONLY.  
NOT TO BE RELIED UPON UNLESS CONFIRMED BY THE SITE INSPECTION AND/OR INVESTIGATION

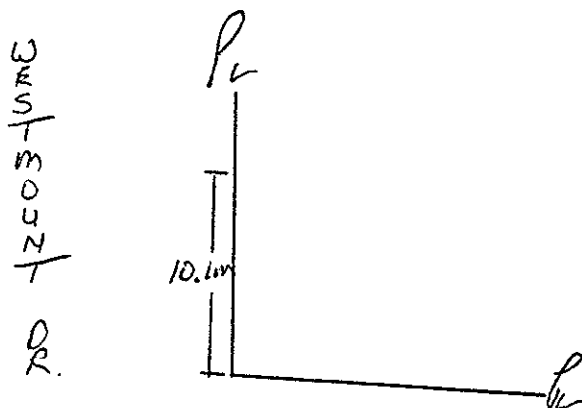


# REPORT TO RECORDS

## WATER SERVICE INFORMATION

Lot No. 41-1605-41802 Block \_\_\_\_\_ D.L. \_\_\_\_\_Address 6856 WESTMOUNT DR.Size of Connection ☐ 1/2" ☒ 3/4" ☐ Other \_\_\_\_\_Type of Connection ☒ Copper ☐ IronThaw Wire ☒ Yes ☐ No

### LOCATION SKETCH

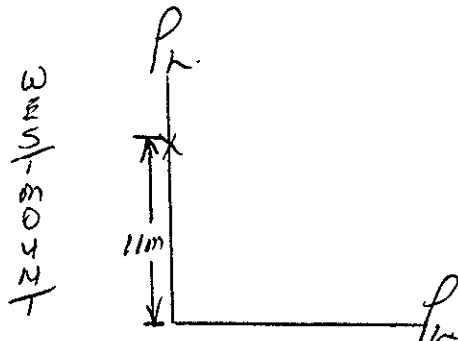
Field Location By L. Pinks Date Nov. 29/00

Checked by: \_\_\_\_\_

**REPORT TO RECORDS**

SEWER SERVICE INFORMATION

Lot No. \_\_\_\_\_ Block \_\_\_\_\_ D.L. \_\_\_\_\_

Address 6856 WILST MOUNT. DR.Size of Connection ☒ 100mm ☐ 150mm ☐ 200mm ☐ Other \_\_\_\_\_Type of Connection ☐ Transite ☒ PVC ☐ Other \_\_\_\_\_Type of Cap ☐ Transite ☒ Cast Iron**LOCATION SKETCH**Field Location By L. Linko Date Nov. 20/00

Checked by Foreman - Sewer Division \_\_\_\_\_