

City of Prince George
HISTORY SHEET

SHEET NUMBER 44 of 81

ROLL NUMBER 023952997

Legal: LOT 44

D.L. 1605

PLAN PGP41802

Address: 6892 WESTMOUNT DRIVE

Sanitary Connection:# SIZE: 100mm ϕ MATERIAL: PVC INV. 739.56m CONNECTED ☒

Water Connection:# FROM MAIN: 19mm ϕ COPPER METER

Storm Connection:# SIZE 100mm ϕ MATERIAL P.V.C. INV. 739.850 m CONNECTED ☒

Cash Receipt No's: WATER SANITARY STORM

CURB FROM PROPERTY LINE 5m PAVEMENT WIDTH 10m

B.C. HYDRO 75mm DB2 U/G CONNECTION

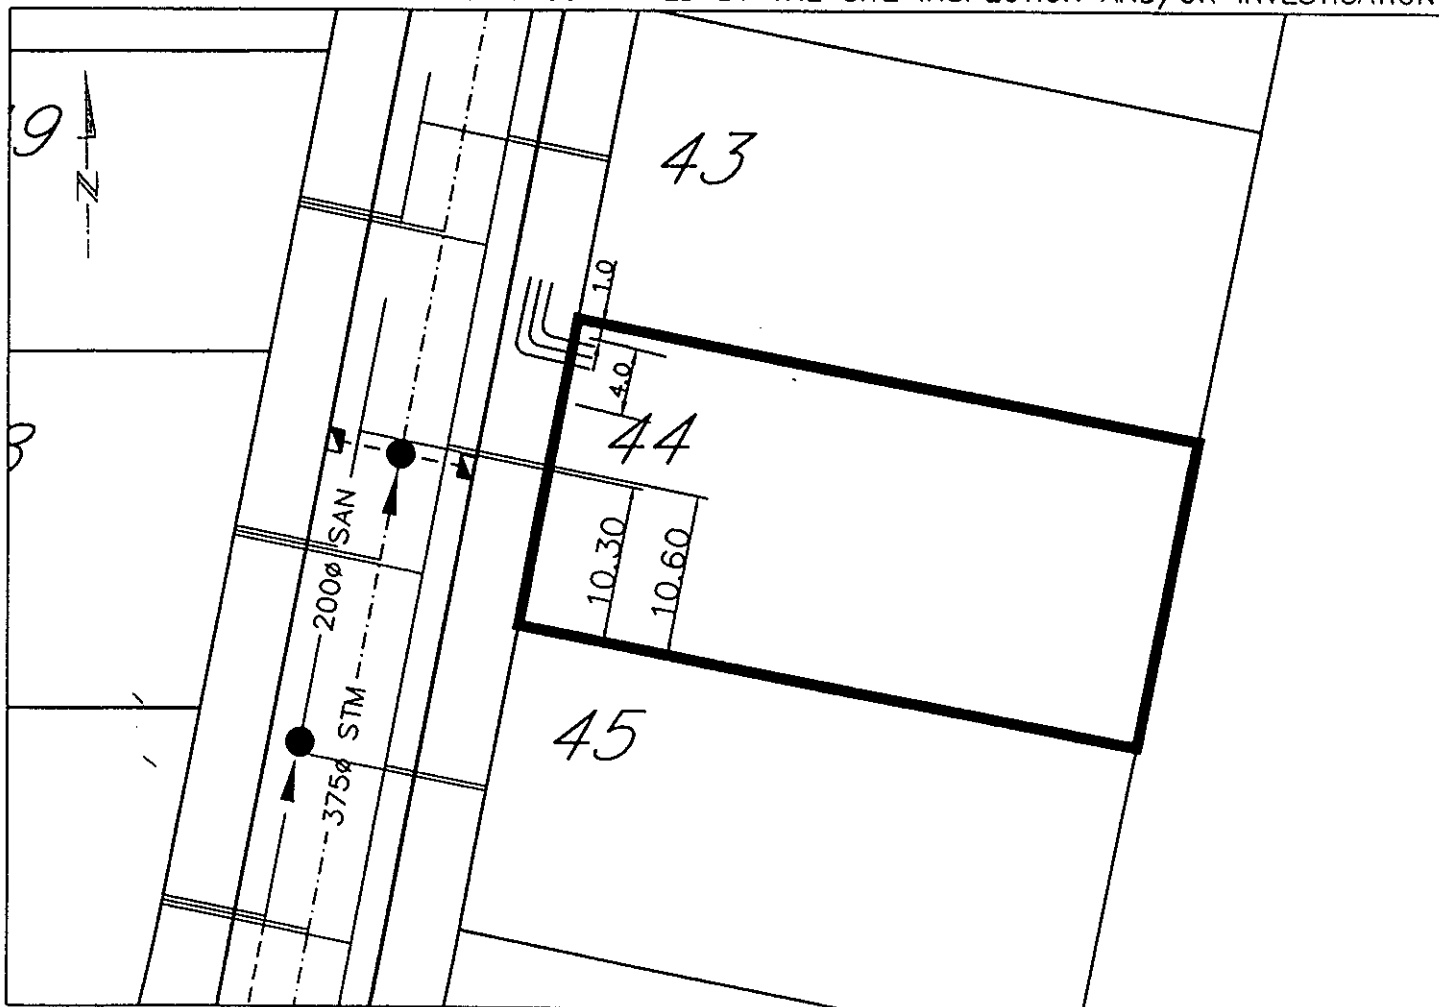
B.C. TELEPHONE 25mm SCHED. 40 U/G CONNECTION

B.C. GAS 15mm ϕ P.E.

Information Sheets: REF. DWGS. L&M ENGINEERING LTD. JOB. 1064-11-02 DWGS.

Comments:

THE INFORMATION CONTAINED HEREIN IS FOR INTERNAL USE ONLY.
NOT TO BE RELIED UPON UNLESS CONFIRMED BY THE SITE INSPECTION AND/OR INVESTIGATION

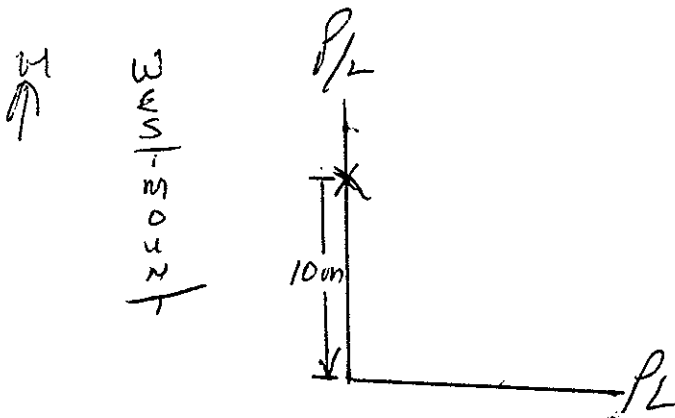


REPORT TO RECORDS

WATER SERVICE INFORMATION

Lot No. 44 Block _____ D.L. _____Address 6892 WEST MOUNT CRESSize of Connection ☐ 1/2" ☒ 3/4" ☐ Other _____Type of Connection ☒ Copper ☐ IronThaw Wire ☒ Yes ☐ No

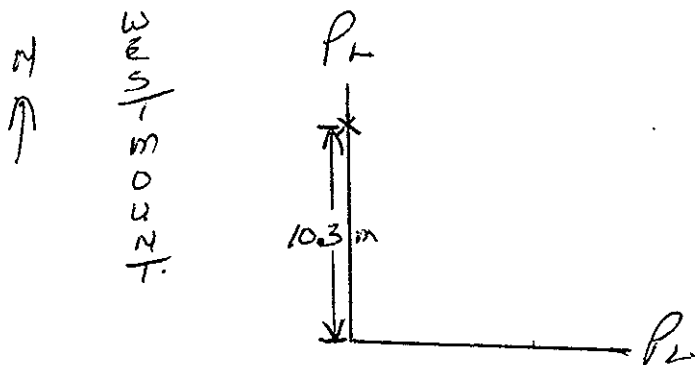
LOCATION SKETCH

Field Location By L. Panko Date Oct. 13/00

Checked by: _____

REPORT TO RECORDS

SEWER SERVICE INFORMATION

Lot No. 44 Block 1605 D.L. 41802Address 6892 WESTMOUNT CRESSize of Connection ☒ 100mm ☐ 150mm ☐ 200mm ☐ OtherType of Connection ☐ Transite ☒ PVC ☐ OtherType of Cap ☐ Transite ☒ Cast Iron**LOCATION SKETCH**Field Location By L. Pinto Date Oct 13/00

Checked by Foreman - Sewer Division _____