



City of Prince George History Sheet

PID:	EPS1818
	023953390
MU:	101472
WO:	54788/43582

Civic Address: 6713 Westmount Dr

Legal Description: Lot: CMPLX District Lot: 2003 Plan: EPS1818

Lot: 84 REM District Lot: 2003 Plan: PGP41802


Service Type	Diameter (mm)	Material	Invert Elev at main (m)	Invert Elev at property line (m)	Invert Elev at service end (m)	Distance into property (m)	Installation Date
Sanitary	200mm	PVC	-	-	-	-	January 1997
Water	200mm	PVC	-	-	-	-	January 1997
Storm	300mm	PVC	-	-	-	-	January 1997

Service Connection Location	Sanitary (m)	Storm (m)
200 Sanitary service connected to San MH4159	-	
300 Storm service connected to Stm MH2324		

Power	Size	Communications	Size	Cable	Size	Gas	Size
BC Hydro	-	Telus	-	Shaw	-	FortisBC	-
Underground Service		Underground Service		Underground Service			

Installed by:	City of Prince George forces	Survey Date:	-
Comments:			

NOT TO SCALE The information contained herein is for internal use only.
Not to be relied on unless confirmed by site inspection and/or investigation.

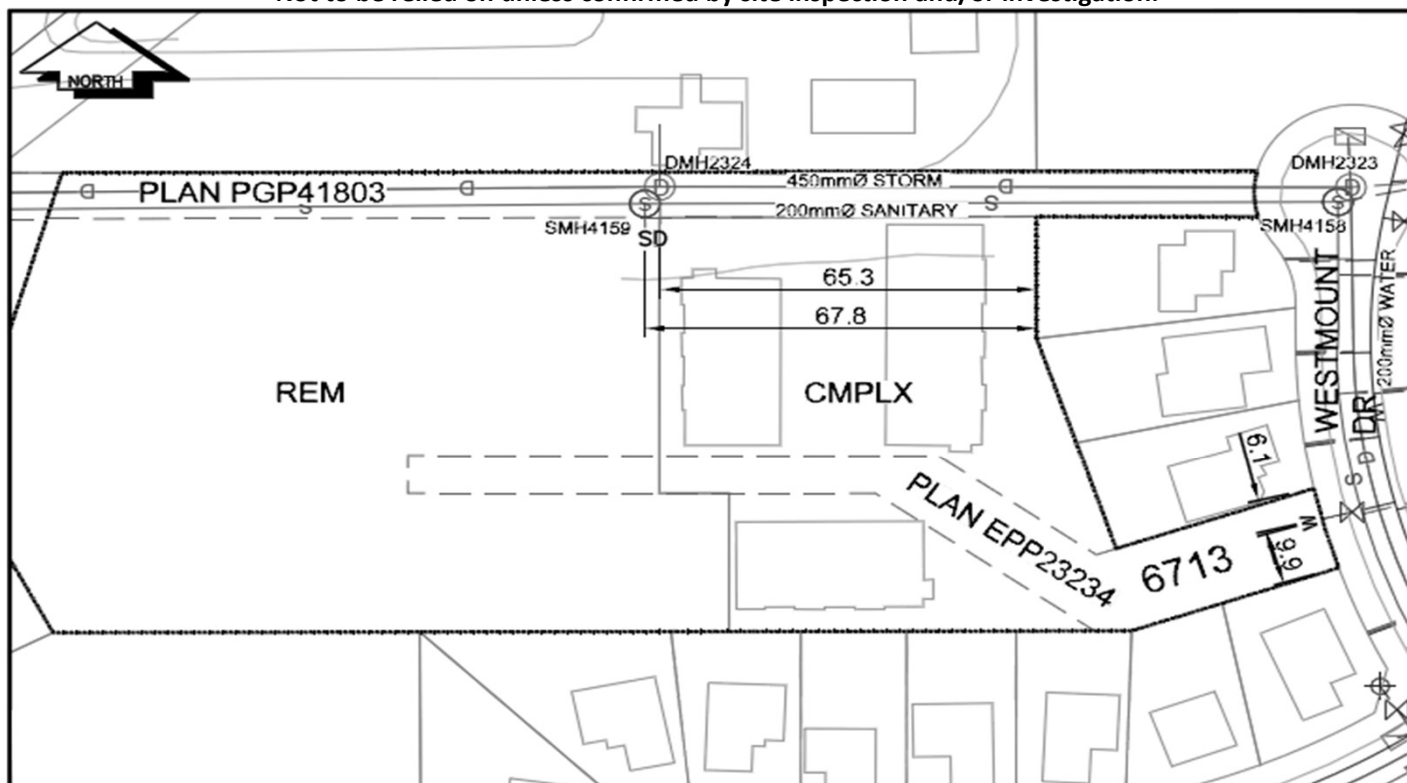

CS CURB STOP	--- WATER SERVICE	--- STORM SERVICE
CO CLEAN OUT	--- SANITARY SERVICE	--- GAS
WATER VALVE	--- FIRE HYDRANT	--- ENCUMBRANCE

NOT TO SCALE