

City of Prince George
HISTORY SHEET

SHEET NUMBER 2 OF 18

ROLL NUMBER 023969962

Legal: LOT 2 BLK D.L. 4048 PLAN P6P41855

Address: 4637 GRAY DRIVE

Sanitary Connection: # SIZE: 100mm MATERIAL: PVC INV. 761.19m CONNECTED

Water Connection: # FROM MAIN: 19mm COPPER METER

Storm Connection: # SIZE 100mm MATERIAL PVC INV. 761.05m CONNECTED

Cash Receipt No's: WATER SANITARY STORM

CURB FROM PROPERTY LINE 5.0m PAVEMENT WIDTH 10.0m

B.C. HYDRO 75mm DB2 U/G CONNECTION

B.C. TELEPHONE 50mm PVC U/G CONNECTION


B.C. GAS 42mm PE SDR10

Information Sheets: REF. DWGS. L&M ENGINEERING LTD. JOB. 1063-05-02

Comments: BENCHMARK: 86H-1856 766.416m

THE INFORMATION CONTAINED HEREIN IS FOR INTERNAL USE ONLY.

NOT TO BE RELIED UPON UNLESS CONFIRMED BY THE SITE INSPECTION AND/OR INVESTIGATION

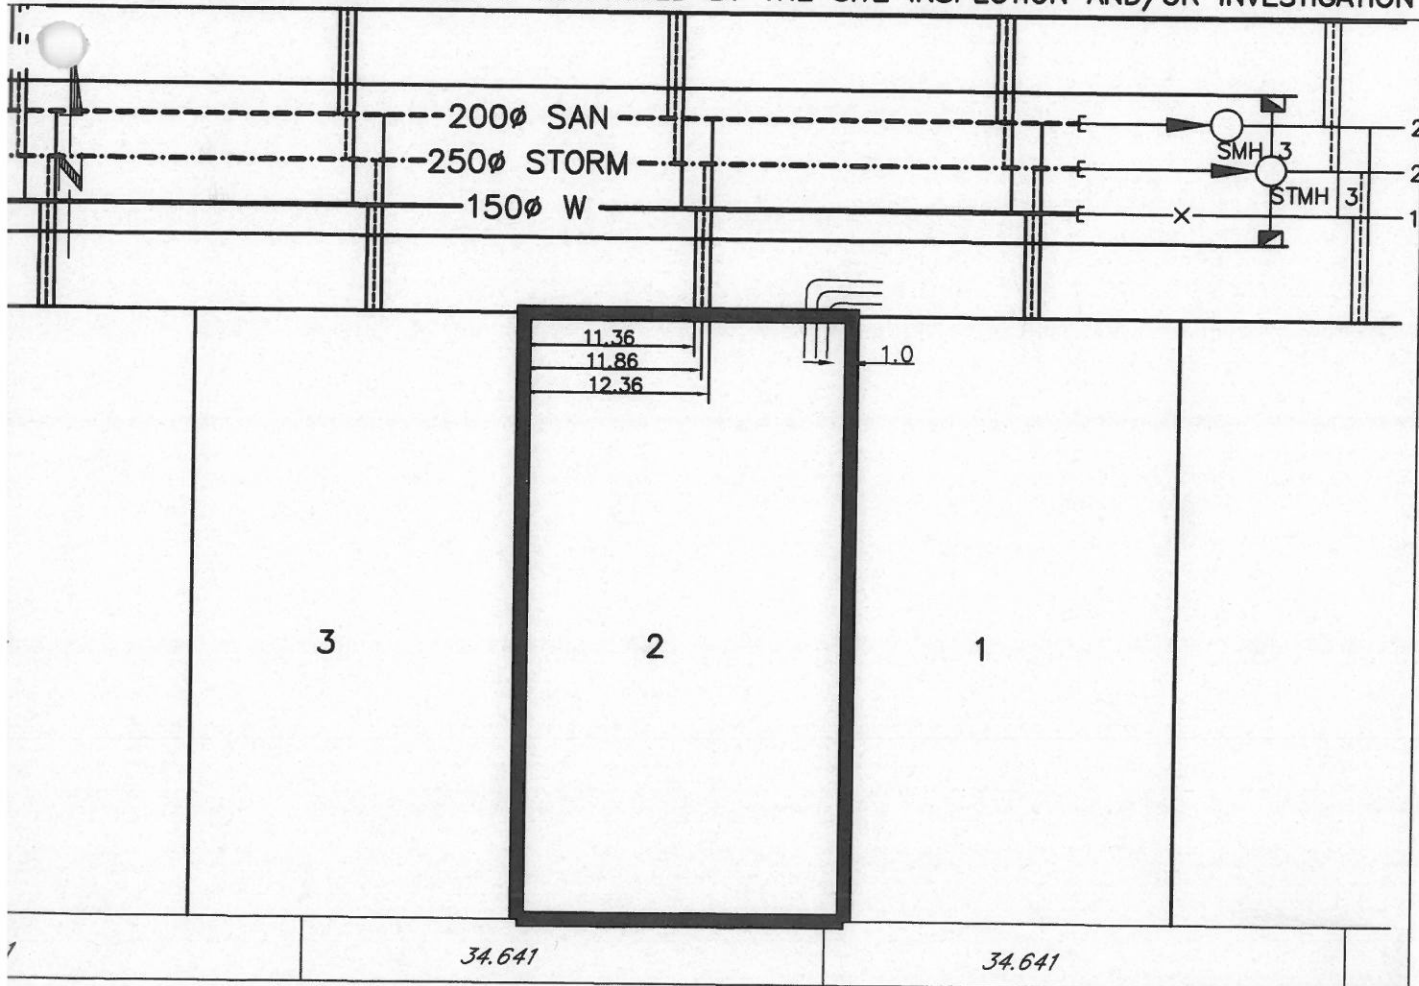

SANITARY & STORM INVERT CALCULATIONS			SANITARY	STORM
1. Distance from San. M.H. 3	to connection point is	toward San. M.H. 4	34.2	
1a. Distance from Stm. M.H. 3	to connection point is	toward Stm. M.H. 4		37.4
2. Calculated invert of main at conn. stub pt is			760.27	760.67
3. Main Size at connection point is			200mm ϕ	250mm ϕ
4. Conn. invert at half diameter (Crown) of main is			760.37	760.80
5. Add to (4) allowance of 0.2 for 1/8 bend adjusted invert now			N/A	N/A
6. Dist. from main to P/L equalsm at% gives rise of			13m @ 6.7% = 0.88m Rise	10m @ 3.0% = 0.30m Rise
7. Item (5) plus (6) equals Calculated Elev. of conn. inv. at P/L equals				
13. Elev. of ref. hub top				766.416
14. Elev. of invert at P/line			761.19	761.05
15. Difference of cut below at property line			2.14	2.28
16. Survey Date	SEPT 19 97	Book Ref. N/A by V.G.		
17. Cut at P/line in feet and inches			7'0"	7'6"

This image shows a single sheet of white paper with horizontal blue or grey ruling lines. On the left edge, there is a circular punch hole, suggesting it was part of a binder. The paper is otherwise blank, with no writing or markings.

This image shows a single sheet of white paper with horizontal blue or grey ruling lines. The lines are evenly spaced and run across the width of the page. There are approximately 20 lines visible. The paper appears to be a standard notebook page.
