

# City of Prince George HISTORY SHEET

SHEET NUMBER 14 OF 18

ROLL NUMBER 023970081

Legal: LOT 14 BLK D.L. 4048 PLAN P674855

Address: 4674 GRAY DRIVE

Sanitary Connection:# SIZE: 100mmØ MATERIAL: PVC INV. 762.76m CONNECTED

Water Connection:# FROM MAIN: 19mmØ COPPER METER

Storm Connection:# SIZE 100mmØ MATERIAL PVC INV. 762.76m CONNECTED

Cash Receipt No's: WATER SANITARY STORM

CURB FROM PROPERTY LINE 5.0m PAVEMENT WIDTH 10.0m

B.C. HYDRO 75mmØ DB2 U/G CONNECTION

B.C. TELEPHONE 50mmØ PVC U/G CONNECTION


B.C. GAS 42mmØ PE SDR10

Information Sheets: REF. DWGS. L&M ENGINEERING LTD. JOB. 1063-05-02

Comments: BENCH MARK: 86H-1856 766.416m

THE INFORMATION CONTAINED HEREIN IS FOR INTERNAL USE ONLY.

NOT TO BE RELIED UPON UNLESS CONFIRMED BY THE SITE INSPECTION AND/OR INVESTIGATION

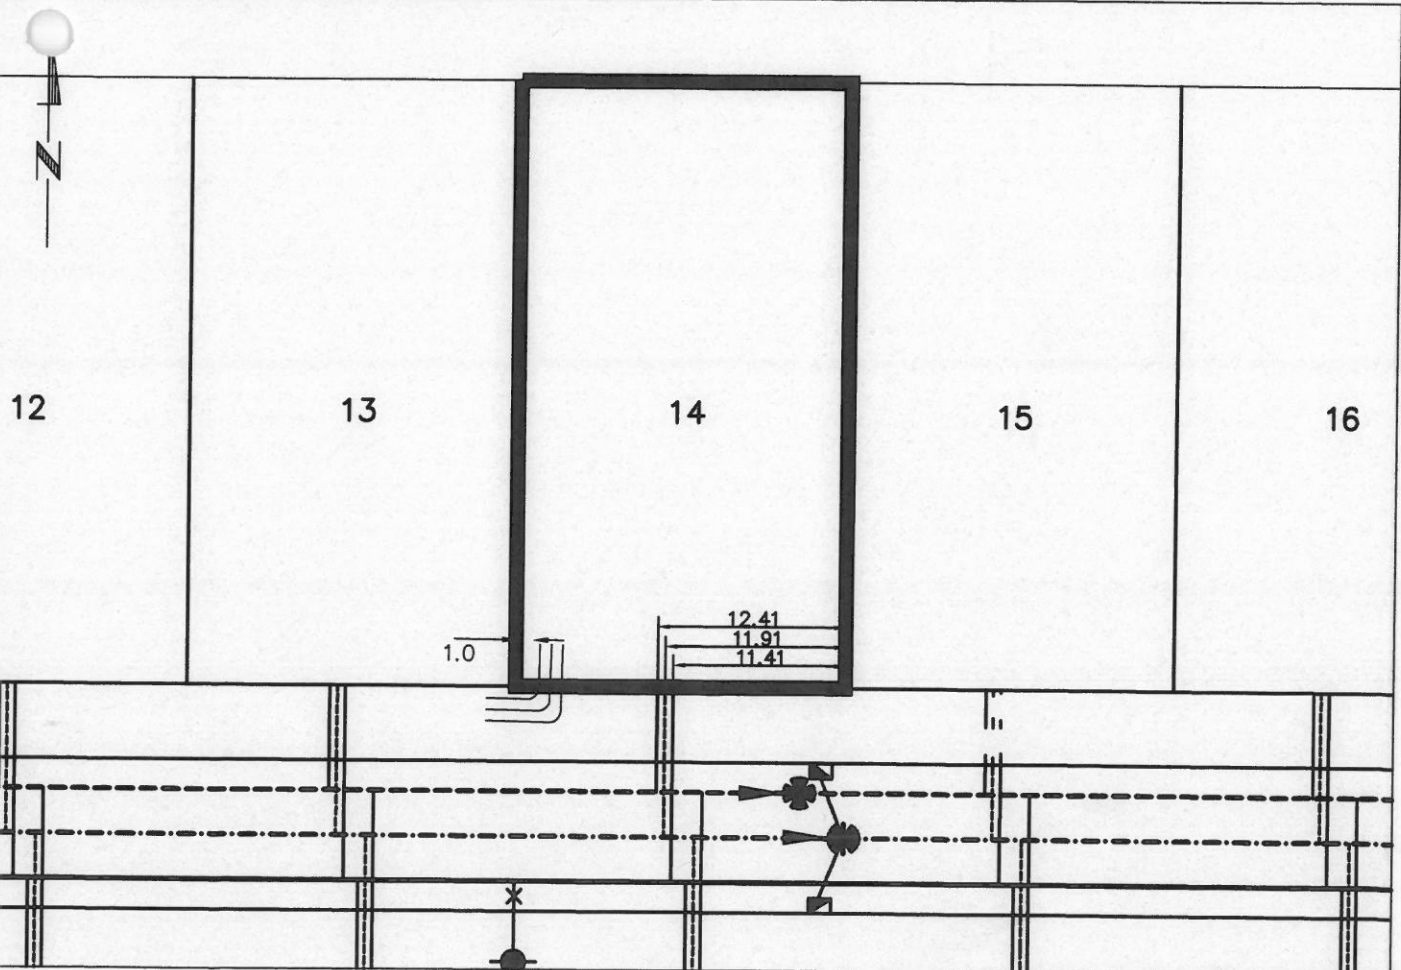

SANITARY & STORM INVERT CALCULATIONS	SANITARY		STORM
1. Distance from San. M.H. 4 to connection point is toward San. M.H. 5	9.2		
1a. Distance from Stm. M.H. 4 to connection point is toward Stm. M.H. 5			12.3
2. Calculated invert of main at conn. stub pt is	761.90		762.29
3. Main Size at connection point is	200mm $\phi$		250mm $\phi$
4. Conn. invert at half diameter (Crown) of main is	762.00		762.42
5. Add to (4) allowance of 0.2 for 1/8 bend adjusted invert now	N/A		N/A
6. Dist. from main to P/L equals .....m at .....% gives rise of	7m @ 11.6% = 0.81m Rise		10m @ 3.5% = 0.35m Rise
7. Item (5) plus (6) equals Calculated Elev. of conn. inv. at P/L equals			
13. Elev. of ref. hub top		766.416	
14. of invert at P/line	762.76		762.76
15. Difference of cut below at property line	2.20		2.20
16. Survey Date SEPT 19 97 Book Ref. N/A by V.G.			
17. Cut at P/line in feet and inches	7'3"		7'3"

[illegible]

## This image shows a single sheet of white paper with horizontal blue or grey ruling lines. The lines are evenly spaced and run across the width of the page. There is no handwriting or other markings on the paper.

[illegible]