



City of Prince George History Sheet

PID:	024134929
SD/MU:	101119
WO:	55388/55389

Civic Address: 6995 Dagg Rd

Legal Description: Lot: 2 District Lot: 4047 Plan: PGP42458


Service Type	Diameter (mm)	Material	Invert Elev at main (m)	Invert Elev at property line (m)	Invert Elev at service end (m)	Distance into property (m)	Installation Date
Sanitary	150mm	PVC	734.43	734.57	734.99	22.20	October 2010
Water	150mm	PVC	-	-	-	-	October 2010
Storm	250mm	PVC	-	-	-	-	October 2010

Service Connection Location	Sanitary (m)	Storm (m)
150mm Sanitary service connected to San MH on Dagg Rd	-	
250mm Storm service acts as pverflow for recharge chamber.		

Power	Size	Communications	Size	Cable	Size	Gas	Size
BC Hydro	-	Telus	-	Shaw	-	FortisBC	-
Overhead Service		Overhead Service		Overhead Service			

Installed by:	City of Prince George forces	Survey Date:	-
Comments:			

NOT TO SCALE The information contained herein is for internal use only.
Not to be relied on unless confirmed by site inspection and/or investigation.

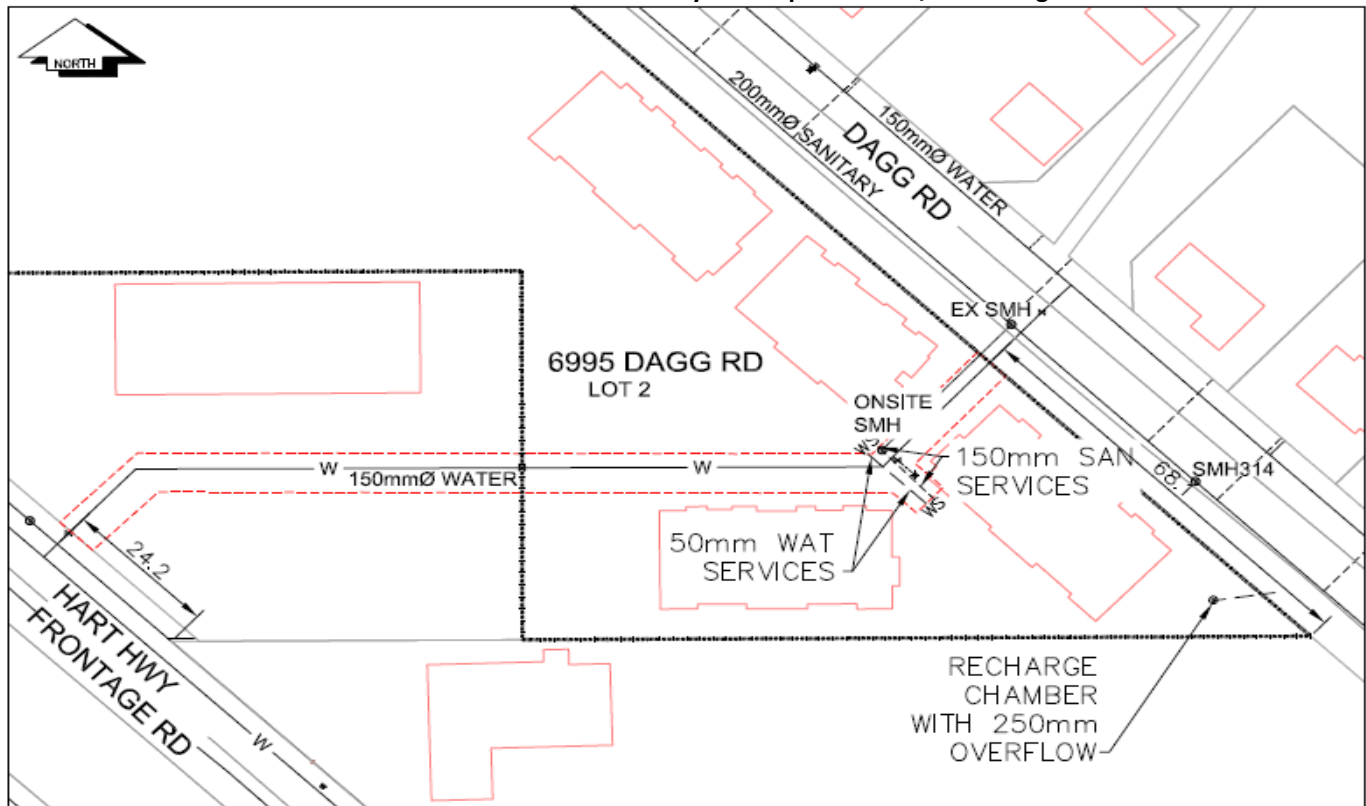

LEGEND:	CS CURB STOP	--- WATER SERVICE	--- STORM SERVICE
	CO CLEAN OUT	--- SANITARY SERVICE	⊗ WATER VALVE

NOT TO SCALE