
City of Prince George HISTORY SHEET

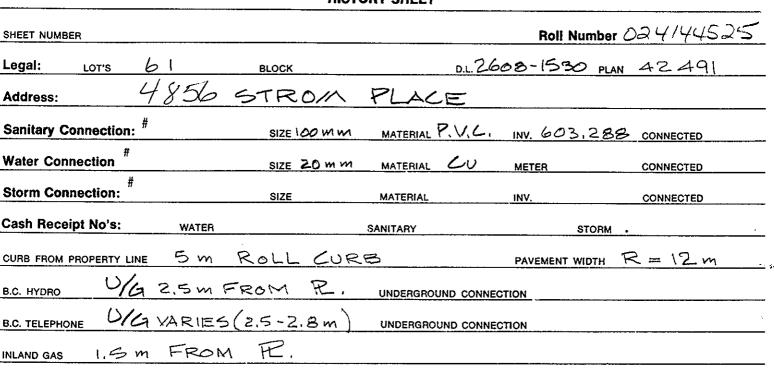

THE INFORMATION CONTAINED HEREIN IS FOR INTERNAL USE ONLY.

NOT TO BE RELIED UPON UNLESS CONFIRMED BY SITE INSPECTION AND/OR INVESTIGATION

Information Sheets:

Comments:

WITH THAW WIRE;

