

City of Prince George  
HISTORY SHEET

SHEET NUMBER

PID # 024153800

Legal: LOT'S 9 BLOCK D.L. 1599 PLAN 42533

Address: 5014 HENRY RD.

Sanitary Connection: # SIZE 100 mm MATERIAL P.V.C. INV. CONNECTED

Water Connection: # SIZE 20 mm MATERIAL CU METER CONNECTED

Storm Connection: # SIZE mm MATERIAL INV. CONNECTED

Cash Receipt No's: WATER 22484 SANITARY 22484 STORM

PAVEMENT CURB FROM PROPERTY LINE 12.192 m PAVEMENT WIDTH 8.000 m

B.C. HYDRO 0/H UNDERGROUND CONNECTION



B.C. TELEPHONE 0/H UNDERGROUND CONNECTION

INLAND GAS

Information Sheets:

Comments:

THE INFORMATION CONTAINED HEREIN IS FOR INTERNAL USE ONLY.  
NOT TO BE RELIED UPON UNLESS CONFIRMED BY SITE INSPECTION AND/OR INVESTIGATION

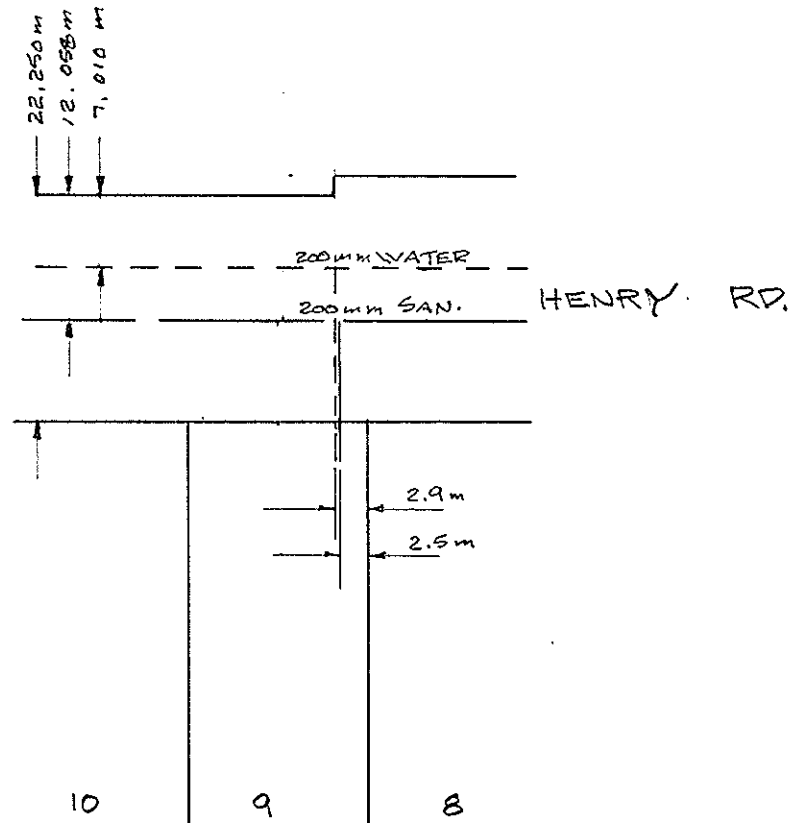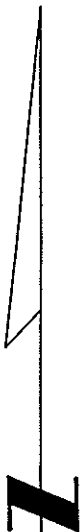

024/53800


## REPORT TO RECORDS

## WATER SERVICE INFORMATION

Lot No. \_\_\_\_\_ Block \_\_\_\_\_ D.L. \_\_\_\_\_

Address 5014 HENRY RDSize of Connection ☐ 1/2" ☒ 3/4" ☐ Other \_\_\_\_\_Type of Connection ☒ Copper ☐ IronThaw Wire ☒ Yes ☐ No

## LOCATION SKETCH

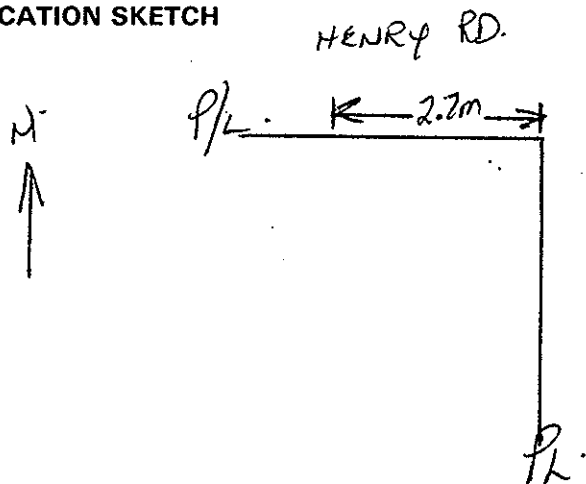
Field Location By L. Panko Date May 8/01

Checked by: \_\_\_\_\_

**REPORT TO RECORDS**

SEWER SERVICE INFORMATION

Lot No. \_\_\_\_\_ Block \_\_\_\_\_ D.L. \_\_\_\_\_

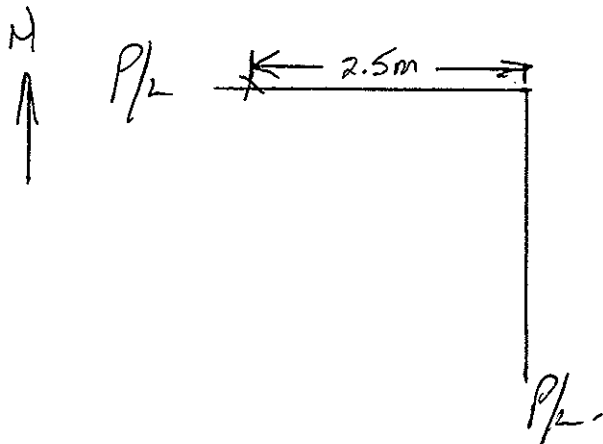Address 5014 HENRY RDSize of Connection ☒ 100mm ☐ 150mm ☐ 200mm ☐ Other \_\_\_\_\_Type of Connection ☐ Transite ☒ PVC ☐ Other \_\_\_\_\_Type of Cap ☐ Transite ☒ Cast Iron**LOCATION SKETCH**Field Location By J. Pardo Date May 8/01

Checked by Foreman - Sewer Division \_\_\_\_\_