



City of Prince George History Sheet

PID:	024161454
SD/MU:	
WO:	

Civic Address: 1517 Blackburn Rd

Legal Description: Lot: 2 District Lot: 632 Plan: PGP42512


Service Type	Diameter (mm)	Material	Invert Elev at main (m)	Invert Elev at property line (m)	Invert Elev at service end (m)	Distance into property (m)	Installation Date
Sanitary	100mm	PVC	-	-	-	-	January 2008
Water	20mm	Copper	-	-	-	-	January 2008
Storm	N/A	N/A	-	-	-	-	

Service Connection Location				Sanitary (m)	Storm (m)
Distance from downstream San MH	6423	towards upstream San MH	3339	66.43	
Distance from downstream Stm MH	-	towards upstream Stm MH	-		

Power	Size	Communications	Size	Cable	Size	Gas	Size
BC Hydro	-	Telus	-	Shaw	-	FortisBC	-
Overhead Service		Overhead Service		Overhead Service			

Installed by:		Survey Date:	-
Comments:	Water service connection confirmed May 2017		

NOT TO SCALE The information contained herein is for internal use only.
Not to be relied on unless confirmed by site inspection and/or investigation.

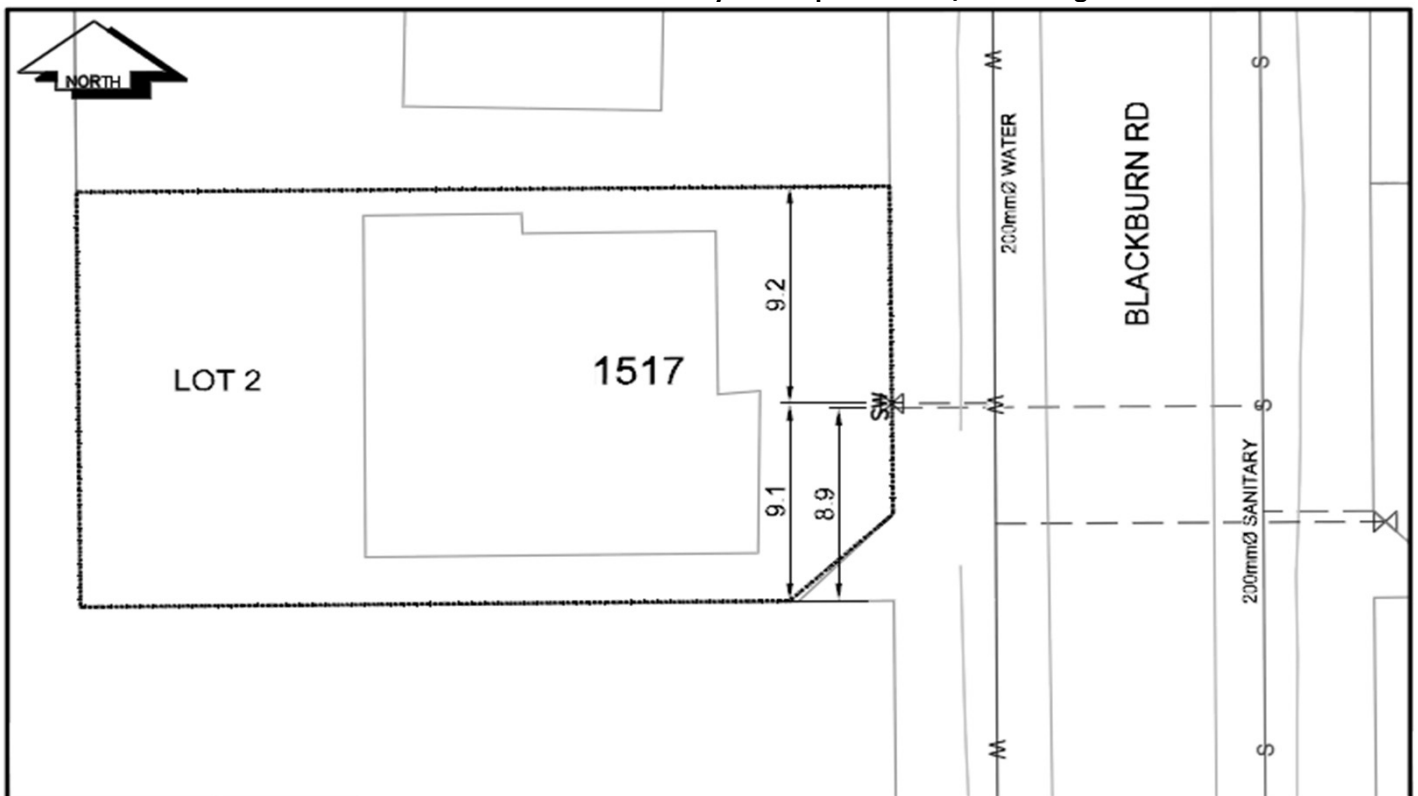

CS ^o CURB STOP	--- WATER SERVICE	--- STORM SERVICE
CO ^o CLEAN OUT	--- SANITARY SERVICE	--- GAS
⊗ WATER VALVE	⊗ FIRE HYDRANT	--- ENCUMBRANCE

NOT TO SCALE