



City of Prince George
History Sheet

PID:	024161888
SD/MU:	
WO:	

Civic Address: 2275 Quinn St
3732 3738 3740 3754 3766 Opie Cres
Legal Description: Lot: 1 District Lot: 2611 Plan: PGP42567


Service Type	Diameter (mm)	Material	Invert Elev at main (m)	Invert Elev at property line (m)	Invert Depth at service end (m)	Distance into property (m)	Installation Date
Sanitary	100mm	AC	-	-	1.52	-	December 1973
Water	50mm	Copper	-	-	-	-	December 1972
Storm	150mm	AC	-	-	1.52	-	December 1973

Service Connection Location	Sanitary (m)	Storm (m)
100mm Sanitary service connected to San MH3438	-	
150mm Storm service connected to Stm MH2695		

Power	Size	Communications	Size	Cable	Size	Gas	Size
BC Hydro	-	Telus	-	Shaw	-	FortisBC	-
Overhead Service		Overhead Service		Overhead Service			

Installed by:	Survey Date:	-
Comments: Sanitary and Storm services run through easement on property to the north of Lot 1		

NOT TO SCALE The information contained herein is for internal use only.
Not to be relied on unless confirmed by site inspection and/or investigation.

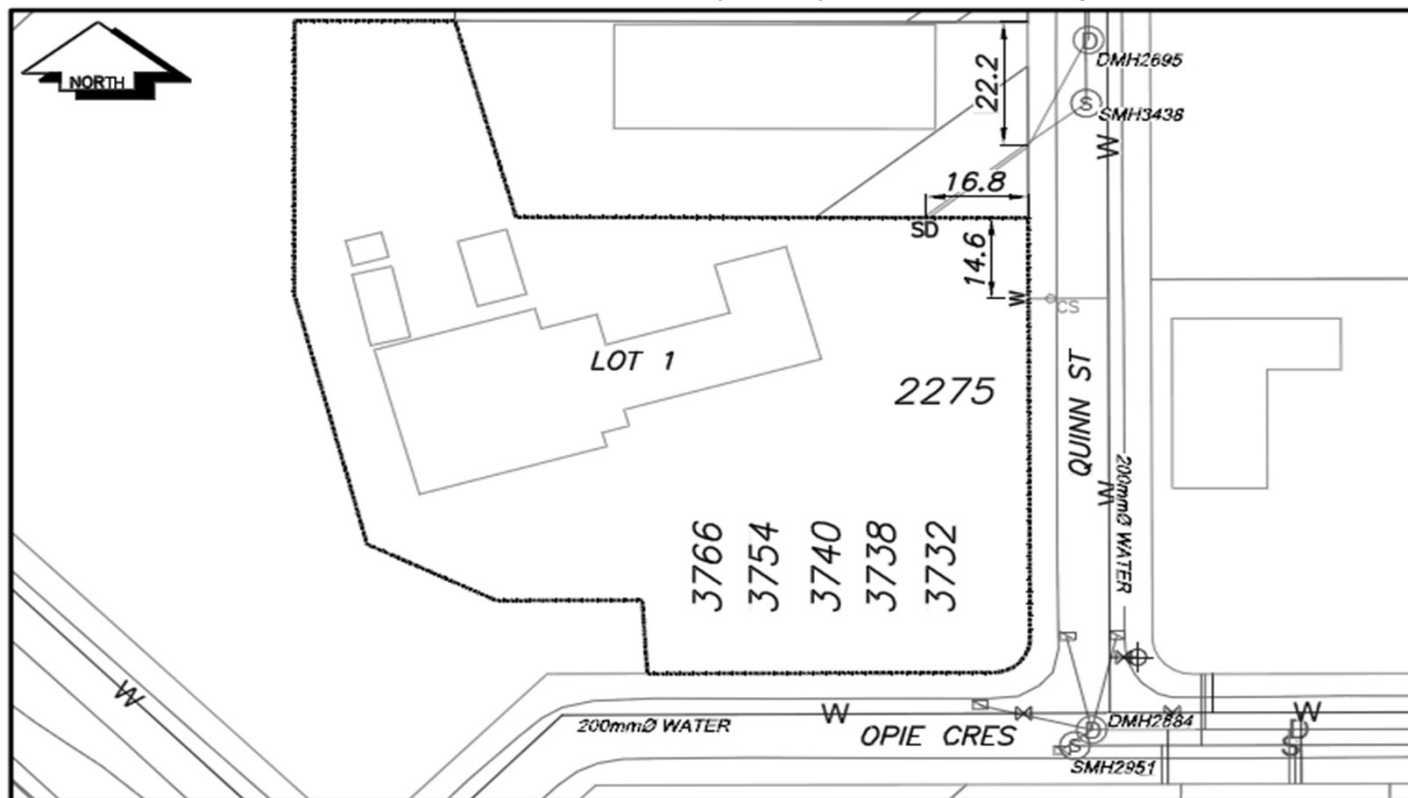

CS	CURB STOP	W	WATER SERVICE	○	STORM SERVICE
CO	CLEAN OUT	S	SANITARY SERVICE	G	GAS
⊗	WATER VALVE	⊕	FIRE HYDRANT	- - -	ENCUMBRANCE

NOT TO SCALE