

PID:	024-161-900
SD/MU:	102441
WO:	

CIVIC ADDRESS: 2259 Quinn Street

LEGAL DESCRIPTION: Lot 3 District Lot 2611 PGP42567


[illegible]

ELECTRICAL / COMMUNICATIONS / GAS

TYPE	PROVIDER	SIZE AND MATERIAL	LOCATION (UNDERGROUND/ OVERHEAD)
ELECTRICAL	BC HYDRO	3x75mm DB2	UNDERGROUND
COMMUNICATION	TELUS	100mm DB2	UNDERGROUND
COMMUNICATION	SHAW	100mm DB2	UNDERGROUND
GAS	FORTISBC	26 P.E.	UNDERGROUND

INFORMATION SHEETS: L&M ENGINEERING LIMITED PROJECT NUMBER 1698-01	SURVEY DATE: June 4, 2021
INSTALLED BY: IDL Projects	
COMMENTS: Civic address 3790 Opie Cres is assigned for the communications tower only	

THE INFORMATION CONTAINED HEREIN IS FOR INTERNAL USE ONLY.
NOT TO BE RELIED UPON UNLESS CONFIRMED BY SITE INVESTIGATION.

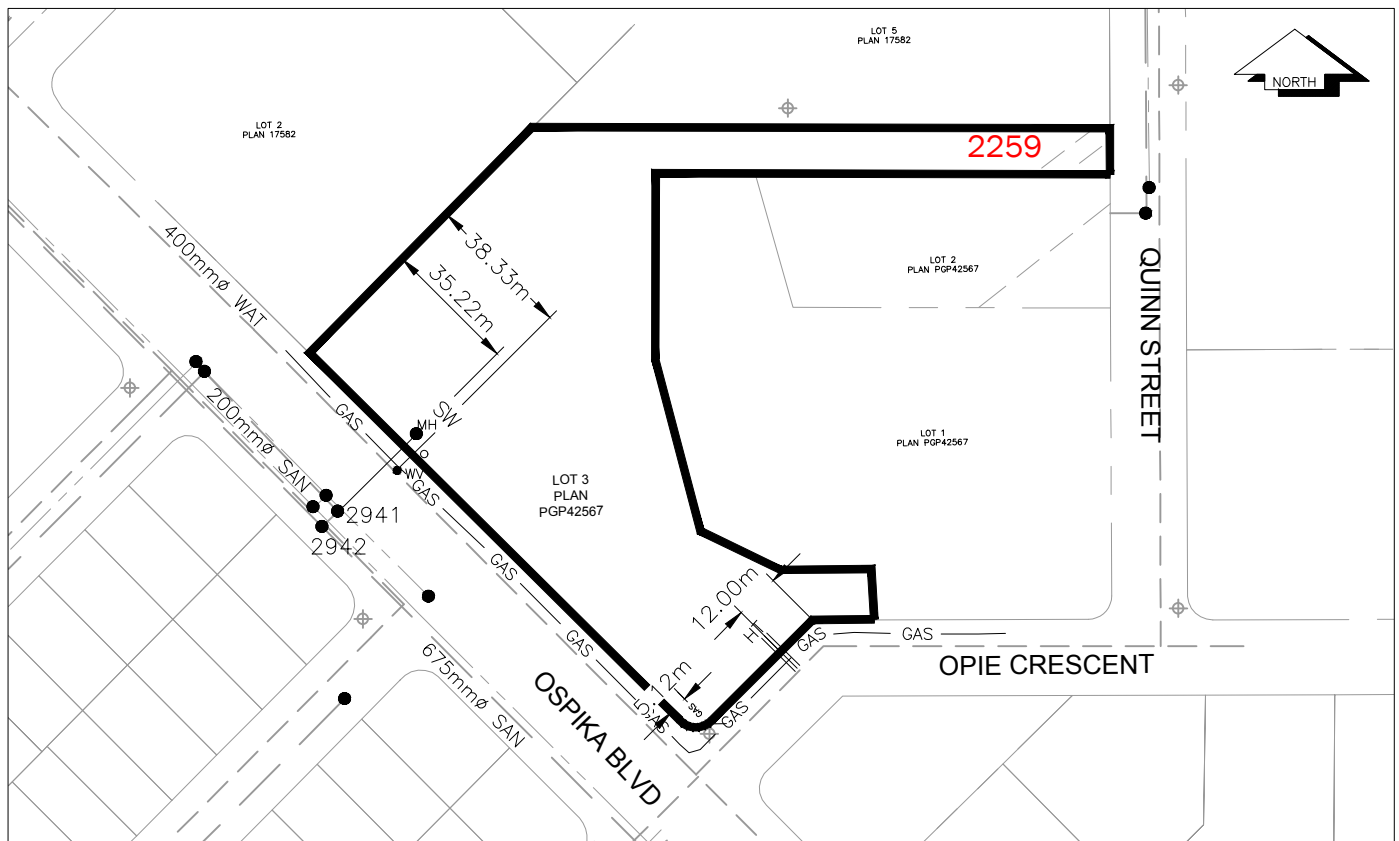

LEGEND:

CS CURB STOP
CO CLEAN OUT

_____ W WATER SERVICE
 _____ D STORM SERVICE
 _____ S SANITARY SERVICE

— I HYDRO SERVICE
— T TELECOMMUNICATIONS

— GAS —	GAS
— UG —	SHALLOW UTILITIES