



City of Prince George History Sheet

PID:	024249025
MU:	101348
WO:	

Civic Address: 5520 Hartway dr

Legal Description: Lot: B District Lot: 4039 Plan: PGP42785


Service Type	Diameter (mm)	Material	Invert Elev at main (m)	Invert Elev at property line (m)	Invert Elev at service end (m)	Distance into property (m)	Installation Date
Sanitary	150mm	PVC	-	-	689.20	-	July 2013
Water	50mm	Copper	-	-	-	-	July 2013
Storm - (D1)	150mm	PVC	688.80	-	688.94	-	July 2013
Storm - (D2)	250mm	PVC	690.05	690.20	690.36	-	July 2013
Storm - (D3)	100mm	PVC	-	-	-	-	July 2013

Service Connection Location				Sanitary (m)	Storm (m)
Distance from downstream San MH	929	towards upstream San MH	612	51.74	
150mm Storm service connected to Stm MH2755					
250mm Storm service connected to Stm MH3990					
Distance from downstream Stm MH	3990	towards upstream Stm MH	3985		13.10

Power	Size	Communications	Size	Cable	Size	Gas	Size
BC Hydro	-	Telus	-	Shaw	-	FortisBC	-
Underground Service		Underground Service		Underground Service			

Installed by:		Survey Date:	-
Comments:	Water, Sanitary, Storm service locations confirmed April 30, 2019		
s			

NOT TO SCALE The information contained herein is for internal use only.
Not to be relied on unless confirmed by site inspection and/or investigation.

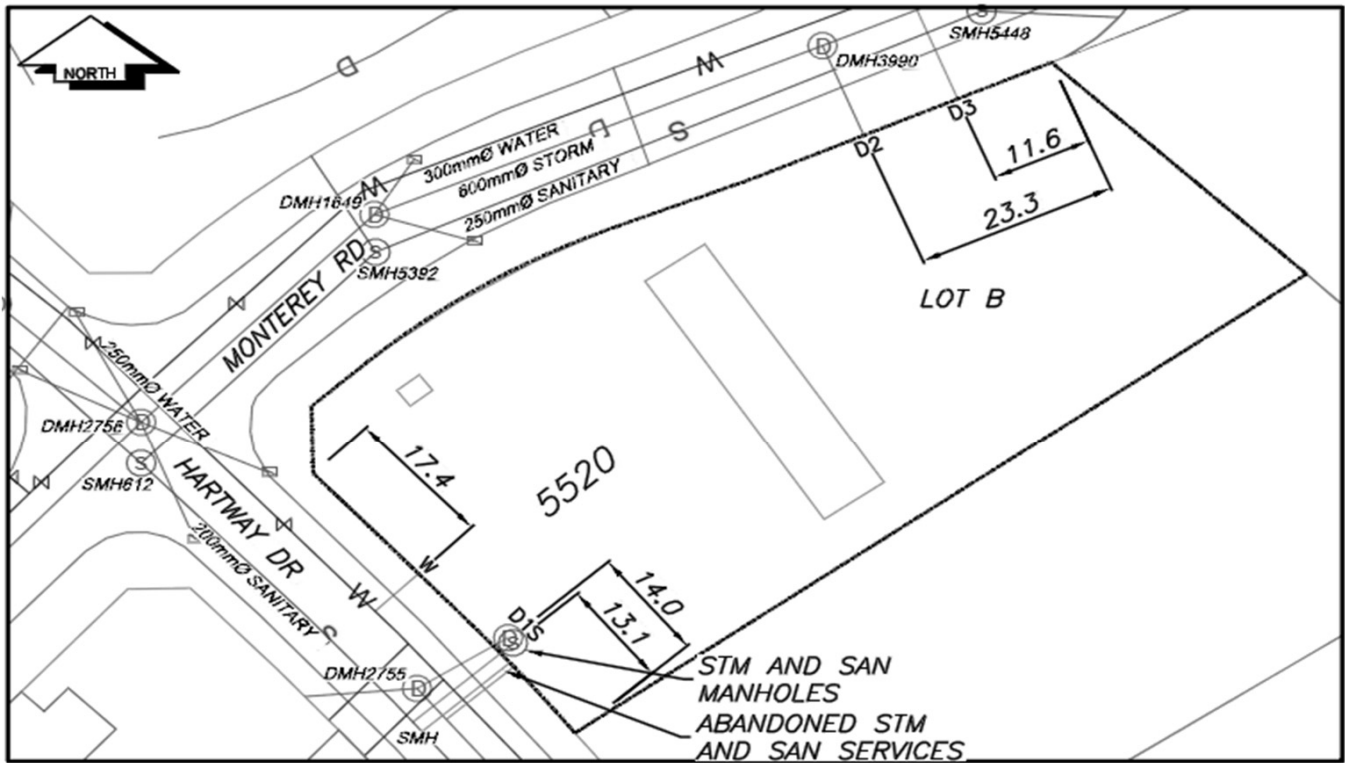

NOT TO SCALE