


Lot Servicing

951 GREAT ST

PID: 024258369

Lot: A, Plan: PGP42972, DL: 485 &DL745

SERVICE	SIZE	MATERIAL	INSTALLED DATE	LOCATION	DETAILS
WATER	100MM	UNKNOWN	02-Nov-1981	FROM NW COR BLDG 1.8M W 2.4M S	CASH RECEIPT NUMBER 391
SANITARY	25MM	UNKNOWN		NO LOCATION GIVEN	CONNECTION # 15235

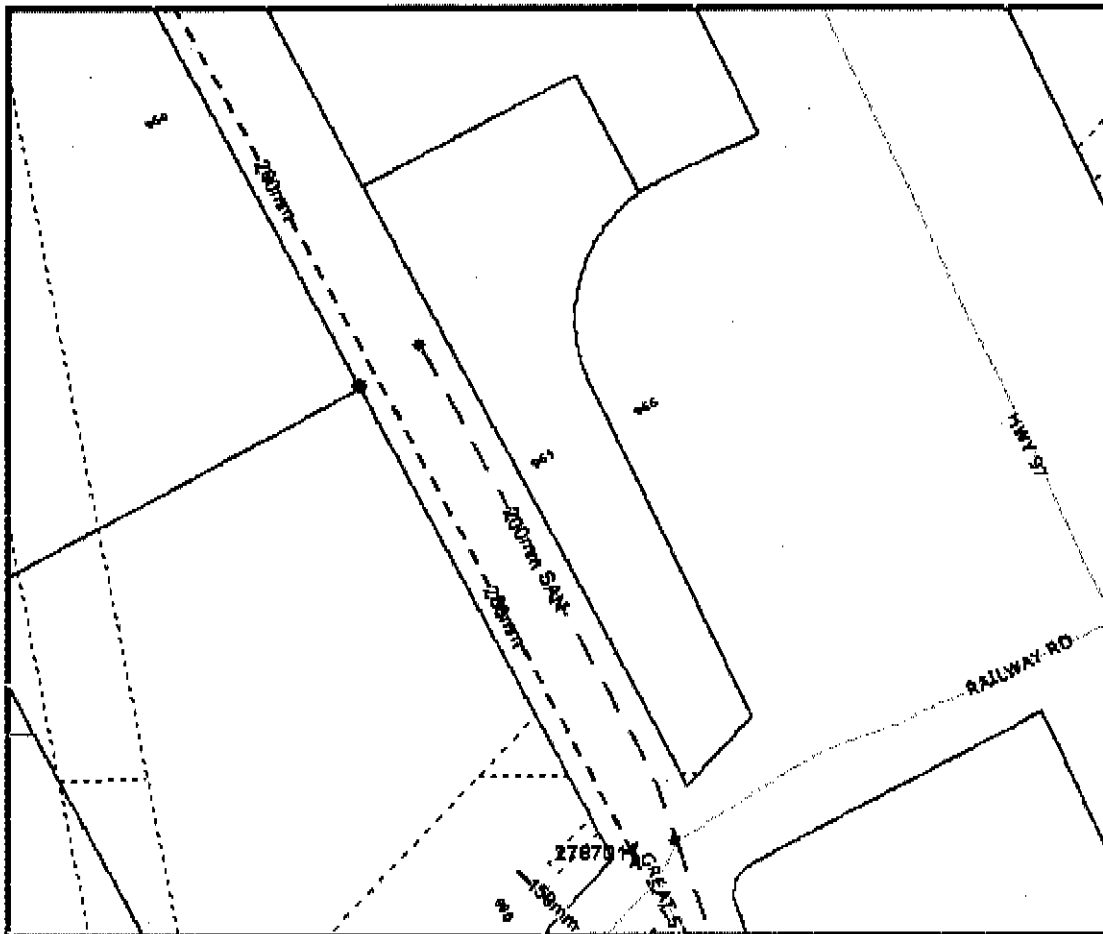

Accuracy not guaranteed unless confirmed by site inspection and/or investigation.
Connection location between main and property line only.