



City of Prince George History Sheet

PID:	024342220
MU:	101702
WO:	86105

Civic Address: 5263 Cook Cres

Legal Description: Lot: 13 District Lot: 4039 Plan: PGP43199


Service Type	Diameter (mm)	Material	Invert Elev at main (m)	Invert Elev at property line (m)	Invert Elev at service end (m)	Distance into property (m)	Installation Date
Sanitary	100mm	PVC	-	-	-	-	January 1998
Water	20mm	Copper	-	-	-	-	January 1998
Storm	100mm	PVC	-	-	-	-	April 2016

Service Connection Location					Sanitary (m)	Storm (m)
Distance from downstream San MH	936	towards upstream San MH	935		66.82	
Distance from downstream Stm MH	2776	towards upstream Stm MH	2777			33.86

Power	Size	Communications	Size	Cable	Size	Gas	Size
BC Hydro	-	Telus	-	Shaw	-	FortisBC	-
Overhead Service		Overhead Service		Overhead Service			

Installed by:	City of Prince George forces	Survey Date:	-
Comments:			

NOT TO SCALE The information contained herein is for internal use only.
Not to be relied on unless confirmed by site inspection and/or investigation.

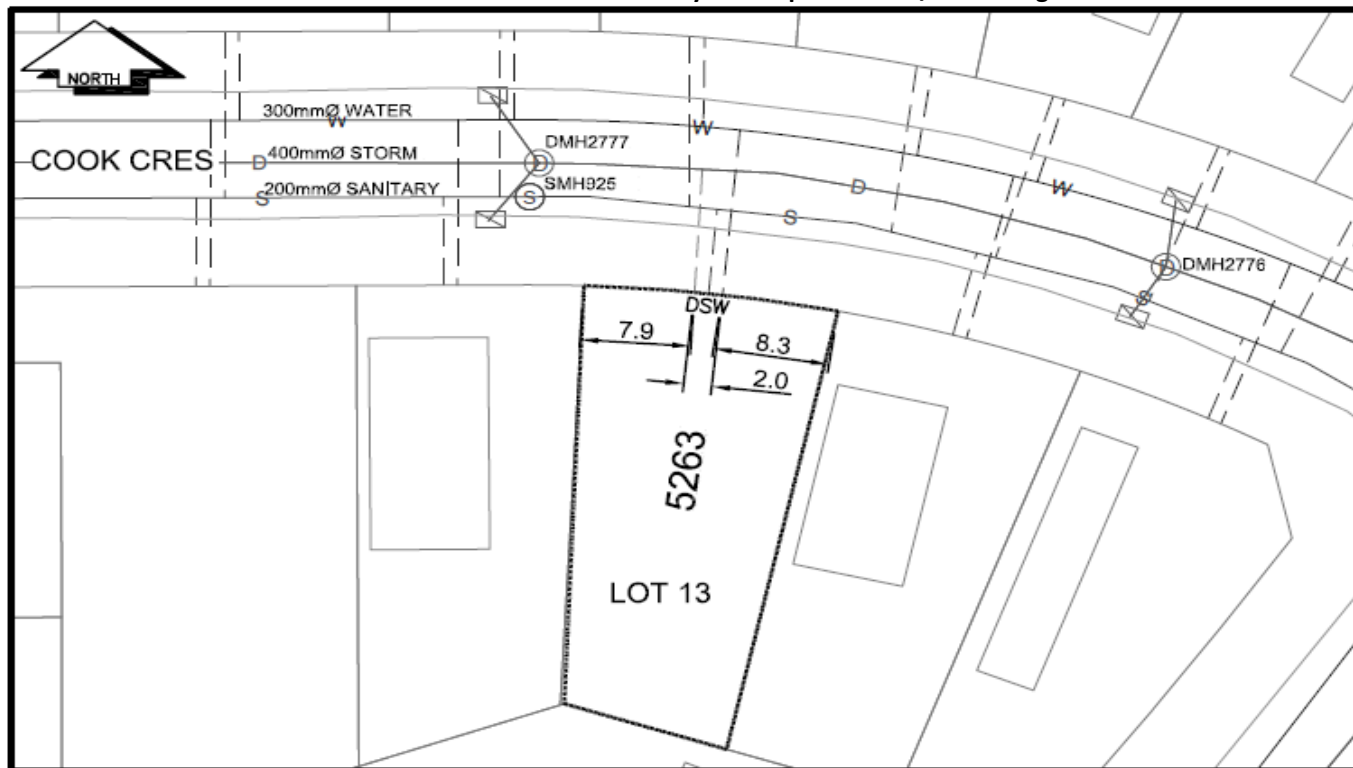

CS ^o CURB STOP	--- W WATER SERVICE	--- S STORM SERVICE
CO ^o CLEAN OUT	--- S SANITARY SERVICE	--- G GAS
⊗ WATER VALVE	⊗ FIRE HYDRANT	--- ENCUMBRANCE

NOT TO SCALE