



City of Prince George History Sheet

PID:	024357316
SD/MU:	
WO:	

Civic Address: 7124 St Gerald Pl

Legal Description: Lot: 2 District Lot: 754 Plan: PGP43287


Service Type	Diameter (mm)	Material	Invert Elev at main (m)	Invert Elev at property line (m)	Invert Elev at service end (m)	Distance into property (m)	Installation Date
Sanitary	100mm	PVC	-	-	-	-	January 1993
Water	20mm	Copper	-	-	-	-	January 1993
Storm	100mm	PVC	-	-	-	-	January 1993

Service Connection Location				Sanitary (m)	Storm (m)
Distance from downstream San MH	4254	towards upstream San MH	4256	71.58	
Distance from downstream Stm MH	490	towards upstream Stm MH	489		72.69

Power	Size	Communications	Size	Cable	Size	Gas	Size
BC Hydro	-	Telus	-	Shaw	-	FortisBC	-
Overhead Service		Overhead Service		Overhead Service			

Installed by:		Survey Date:	-
Comments:	Water and Sanitary services locations confirmed April 2019		

NOT TO SCALE The information contained herein is for internal use only.
Not to be relied on unless confirmed by site inspection and/or investigation.

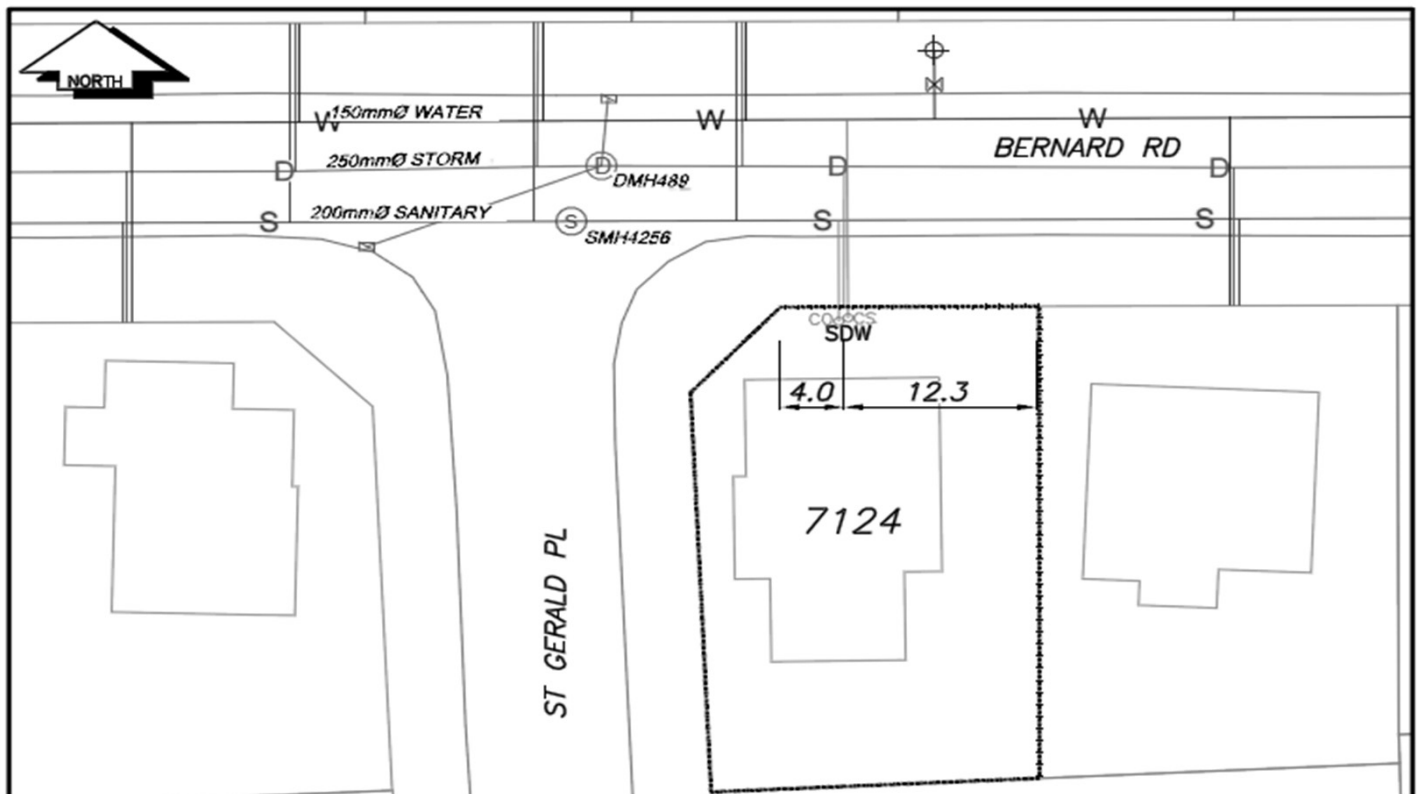

CS ^o CURB STOP	W WATER SERVICE	o STORM SERVICE
CO ^o CLEAN OUT	- - - - - S SANITARY SERVICE	- G GAS
WATER VALVE	⊕ FIRE HYDRANT	- - - - - ENCUMBRANCE

NOT TO SCALE