

City of Prince George  
HISTORY SHEET

SHEET NUMBER

PID # 024365068

Legal: LOT'S 2 BLOCK D.L. 4040 PLAN 43492

Address: 4388 FEHR RD.

Sanitary Connection: # 13197 SIZE 100 mm MATERIAL A.C. INV. 650.079 CONNECTED

Water Connection: # SIZE 20 mm MATERIAL C.U. METER CONNECTED

Storm Connection: # SIZE mm MATERIAL INV. CONNECTED

Cash Receipt No's: WATER SANITARY 1945 STORM

CURB FROM PROPERTY LINE 4.877 m PAVEMENT WIDTH 10.363 m

B.C. HYDRO O/H UNDERGROUND CONNECTION


B.C. TELEPHONE O/H UNDERGROUND CONNECTION

INLAND GAS 3.657 m FROM R.

Information Sheets:

Comments: WITH THAW WIRE.

THE INFORMATION CONTAINED HEREIN IS FOR INTERNAL USE ONLY.  
NOT TO BE RELIED UPON UNLESS CONFIRMED BY SITE INSPECTION AND/OR INVESTIGATION

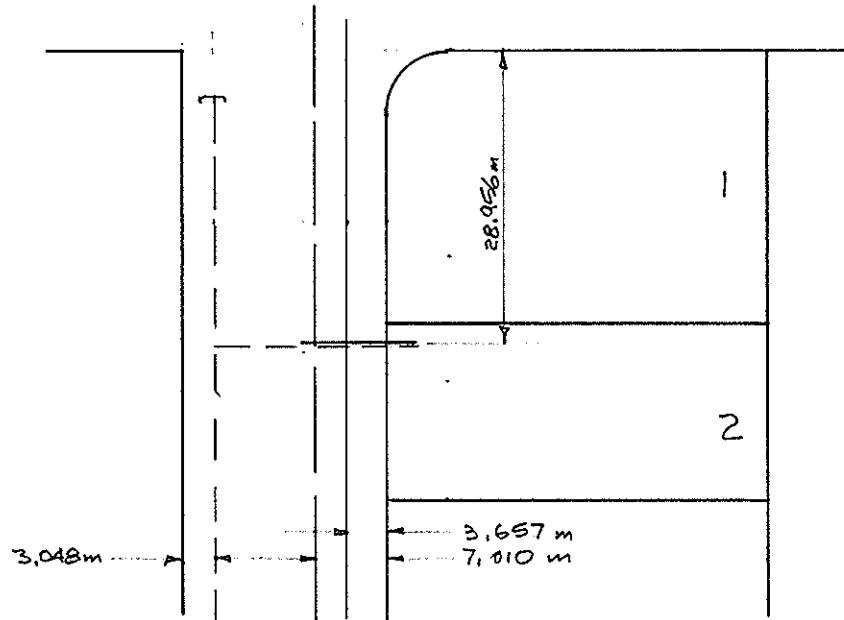

R  
H  
D.  
R