



City of Prince George
History Sheet

PID:	024396346
SD/MU:	
WO:	

Civic Address: 2999 3055 3115 3117 3161 3173 3185 3199 Massey Dr

Legal Description: Lot: A & DL 8176, 1430, 8180, 8172 District Lot: 8173 Plan: PGP43619

Service Type	Diameter (mm)	Material	Invert Elev at main (m)	Invert Elev at property line (m)	Invert Elev at service end (m)	Distance into property (m)	Installation Date
Sanitary	Unknown	Unknown	-	-	-	-	-
Water (W1)	250mm	AC	-	-	-	-	January 1967
Water (W2)	250mm	AC	-	-	-	-	January 1967
Storm	Unknown	Unknown	-	-	-	-	

Service Connection Location					Sanitary (m)	Storm (m)
Distance from downstream San MH	-	towards upstream San MH	-		-	
Distance from downstream Stm MH	-	towards upstream Stm MH	-			


Power	Size	Communications	Size	Cable	Size	Gas	Size
BC Hydro	-	Telus	-	Shaw	-	FortisBC	-
Underground Service		Underground Service		Underground Service			

Installed by:	Survey Date:	-
Comments:		

NOT TO SCALE The information contained herein is for internal use only.
Not to be relied on unless confirmed by site inspection and/or investigation.

See drawing on next page

NOT TO SCALE

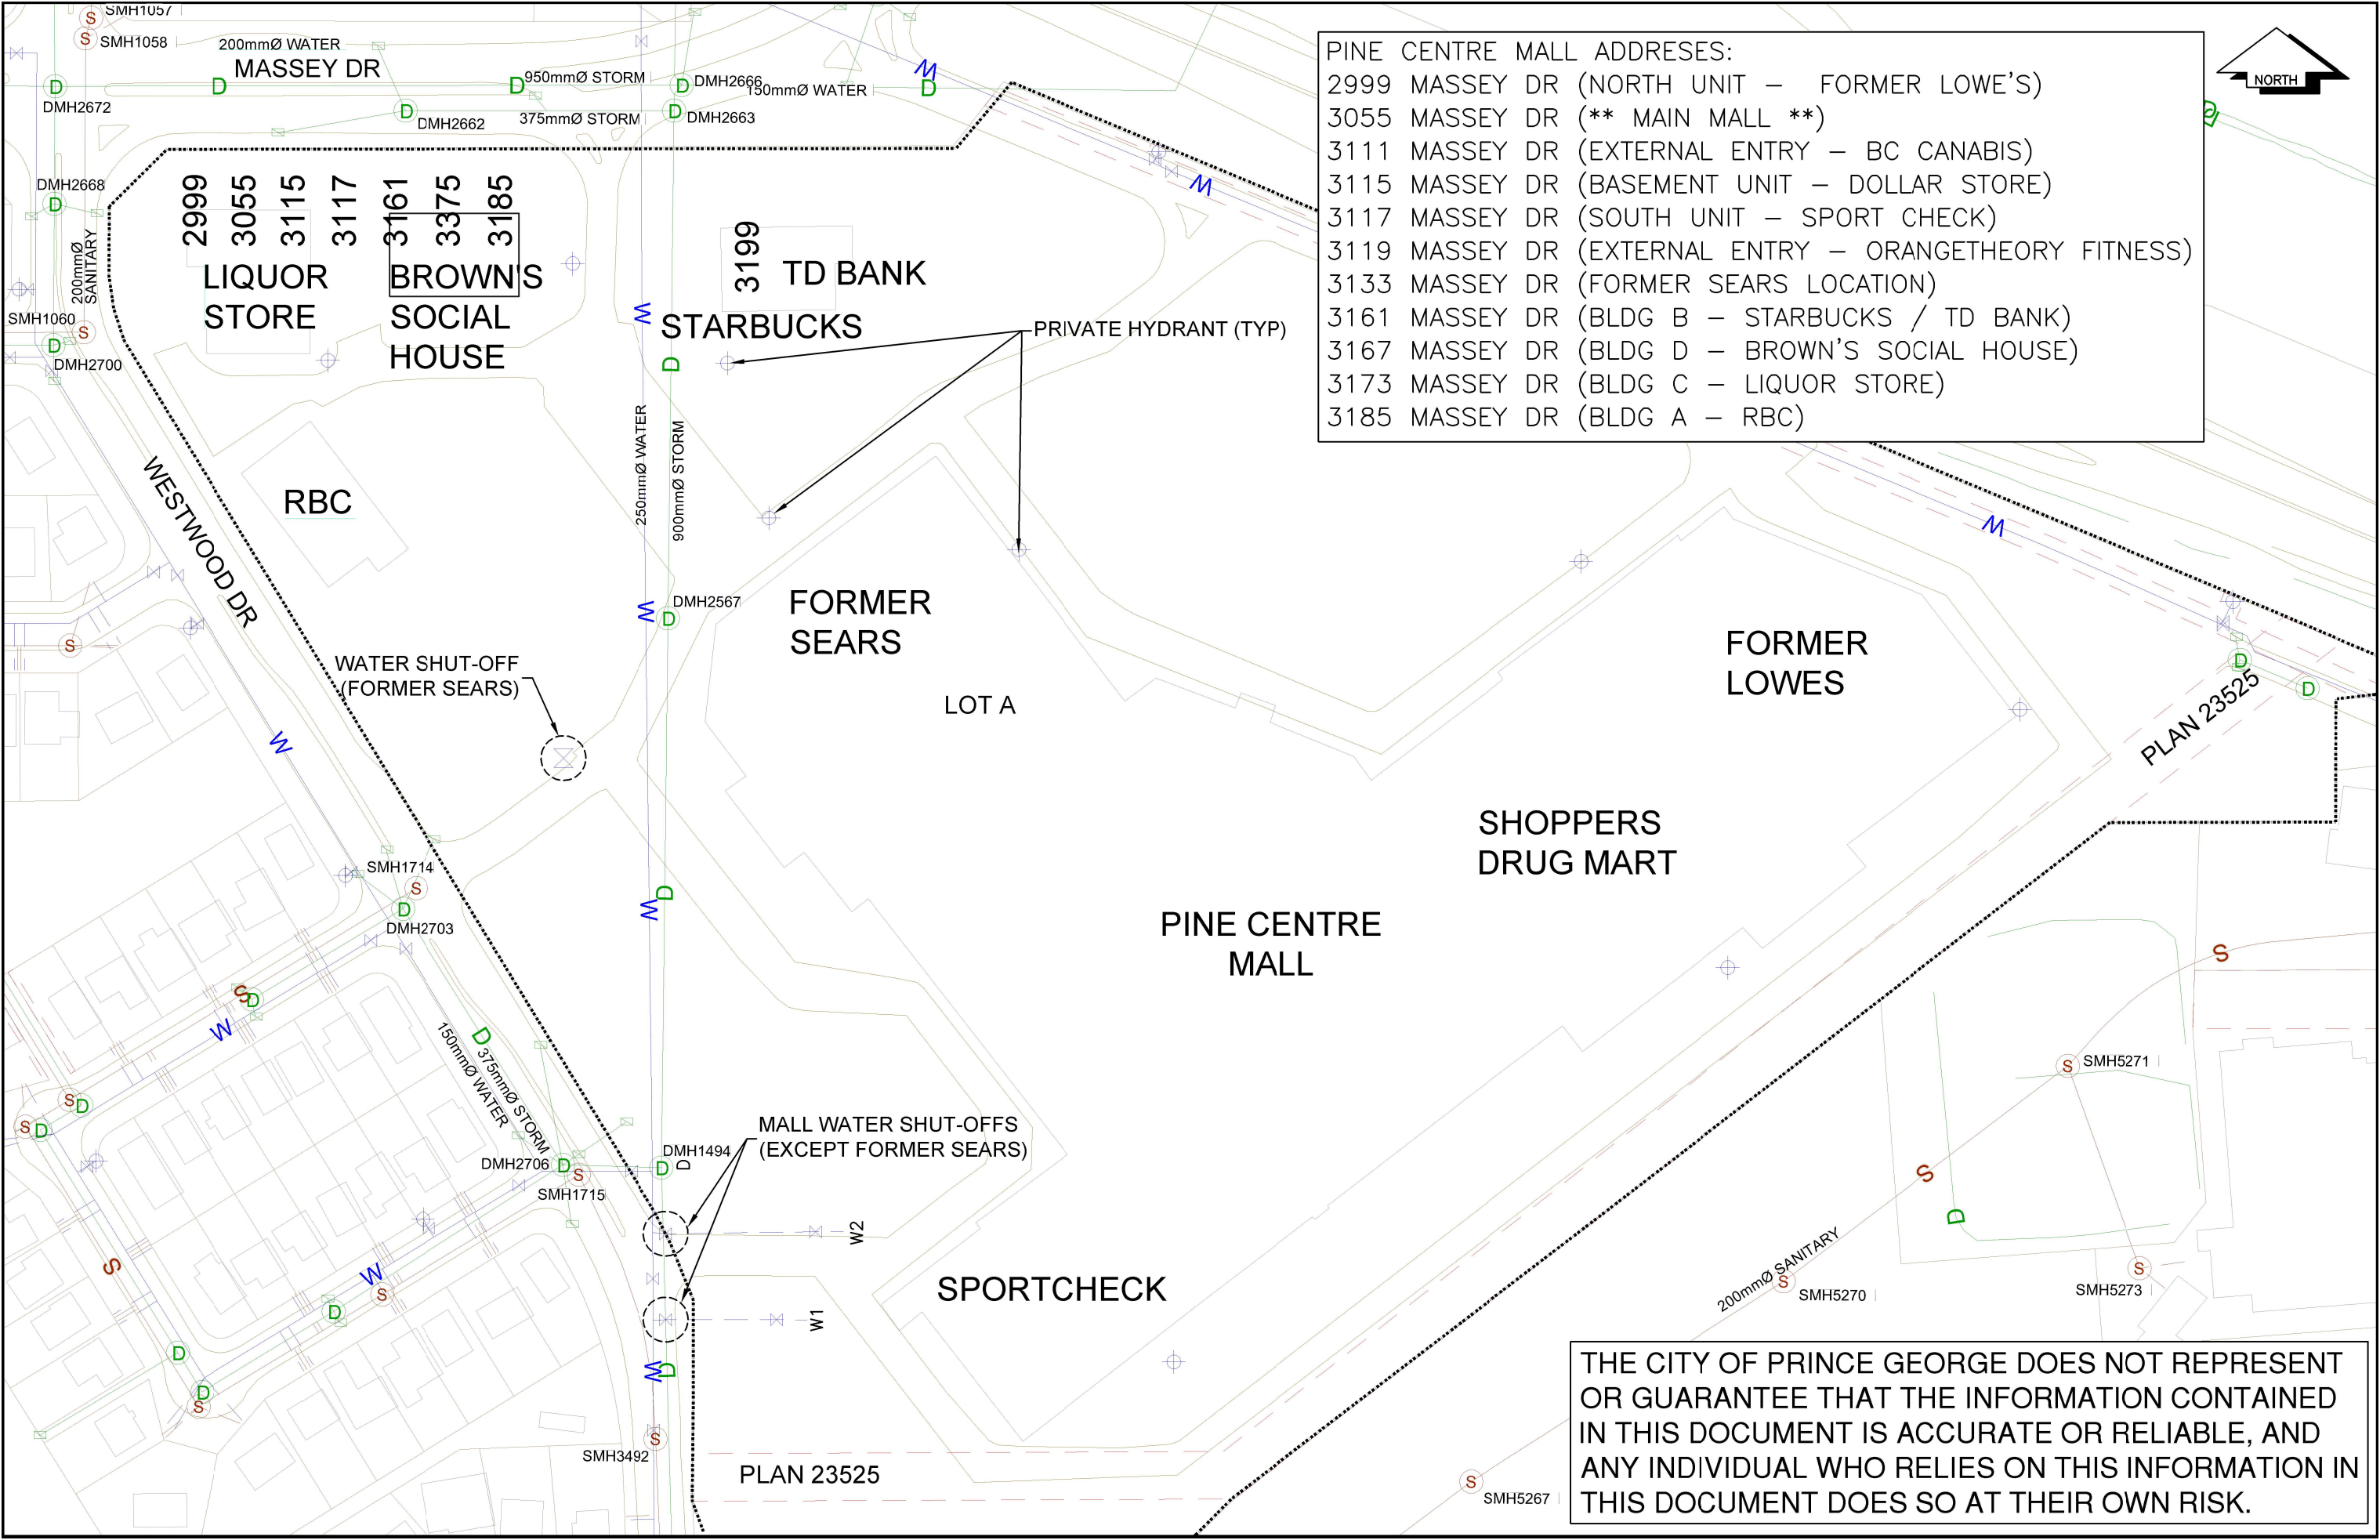

- PINE CENTRE MALL ADDRESSES:
- 2999 MASSEY DR (NORTH UNIT – FORMER LOWE’S)
 - 3055 MASSEY DR (** MAIN MALL **)
 - 3111 MASSEY DR (EXTERNAL ENTRY – BC CANABIS)
 - 3115 MASSEY DR (BASEMENT UNIT – DOLLAR STORE)
 - 3117 MASSEY DR (SOUTH UNIT – SPORT CHECK)
 - 3119 MASSEY DR (EXTERNAL ENTRY – ORANGETHEORY FITNESS)
 - 3133 MASSEY DR (FORMER SEARS LOCATION)
 - 3161 MASSEY DR (BLDG B – STARBUCKS / TD BANK)
 - 3167 MASSEY DR (BLDG D – BROWN’S SOCIAL HOUSE)
 - 3173 MASSEY DR (BLDG C – LIQUOR STORE)
 - 3185 MASSEY DR (BLDG A – RBC)

THE CITY OF PRINCE GEORGE DOES NOT REPRESENT OR GUARANTEE THAT THE INFORMATION CONTAINED IN THIS DOCUMENT IS ACCURATE OR RELIABLE, AND ANY INDIVIDUAL WHO RELIES ON THIS INFORMATION IN THIS DOCUMENT DOES SO AT THEIR OWN RISK.