
City of Prince George WHISTORY SHEET

SHEET NUMBER						Roll Number <i>0</i> 24478890				
Legal:	LOT'S	6	BLOCK			о.к. <i>43</i> 77		plan <i>P6P4</i> 3880)
Address:	2308	MCTA	WISH	ROAL			•			
Sanitary Connection: #			SIZE	100 mm	MATERIAL	PVC	INV.	649.18	CONNECTED	
Water Connection #			SIZE	25 mm	MATERIAL	Cu	METER		CONNECTED	·
Storm Connection: #			SIZE	20mm	MATERIAL	RVC	INV.	649.58	CONNECTED	
Cash Receipt No's:		WATER	7-2-7	<u> </u>	SANITARY			STORM		
SURB FROM PROPERTY LINE							PAVEM	ENT WIDTH		
3.C. HYDRO		UNDERGROUND CONNECTION								
B.C. TELEPHONE		UNDERGROUND CONNECTION								
NLAND GAS		-							,	
Information	Sheets:		·	<u>. </u>						
Comments:		····								

THE INFORMATION CONTAINED HEREIN IS FUR INTERNAL USE ONLY.

NOT TO BE RELIED UPON UNLESS CONFIRMED BY SITE INSPECTION AND/OR INVESTIGATION

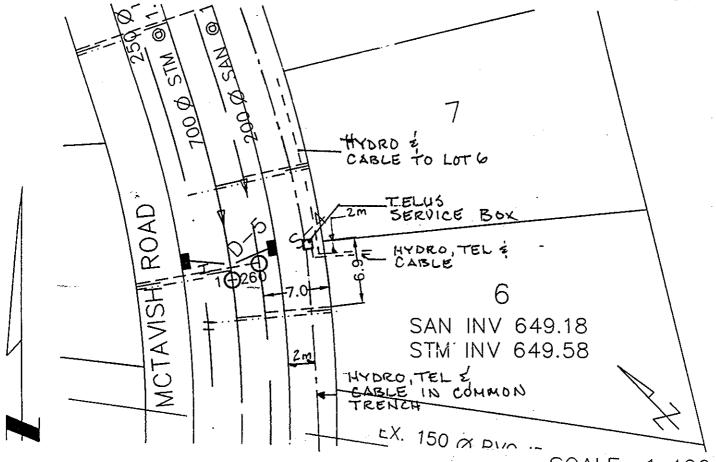

SCALE: 1:400