
## City of Prince George HISTORY SHEET

SHEET NUMBER Roll Number 024478903										
Legal:	LOT'S	7	BLOCK			D.L.	<i>4</i> 377	PLAN	PGP43880	
Address:	2316	MCTA	WISH	ROAL	<u> </u>					
Sanitary Co	nnection: #		SIZE	100mm	MATERIAL	PVC	INV.	640.06	CONNECTED	
Water Connection #			SIZE	25 mm	MATERIAL	<u></u>	METER	·*·······	CONNECTED	
Storm Connection: #			SIZE	100mm	MATERIAL	PVC	INV.	649.47	CONNECTED	
Cash Receipt No's:		WATER		·s	SANITARY			STORM		
CURB FROM PROPERTY LINE			PAVEMENT WIDTH							
3.C. HYDRO		UNDERGROUND CONNECTION								
B.C. TELEPHONE			UNDERGROUND CONNECTION							
NLAND GAS			<u>:</u>	•- ·	-					
Information Sheets:										
Comments:		•						f		

## THE INFORMATION CONTAINED HEREIN IS FOR INTERNAL USE ONLY. NOT TO BE RELIED UPON UNLESS CONFIRMED BY SITE INSPECTION AND/OR INVESTIGATION

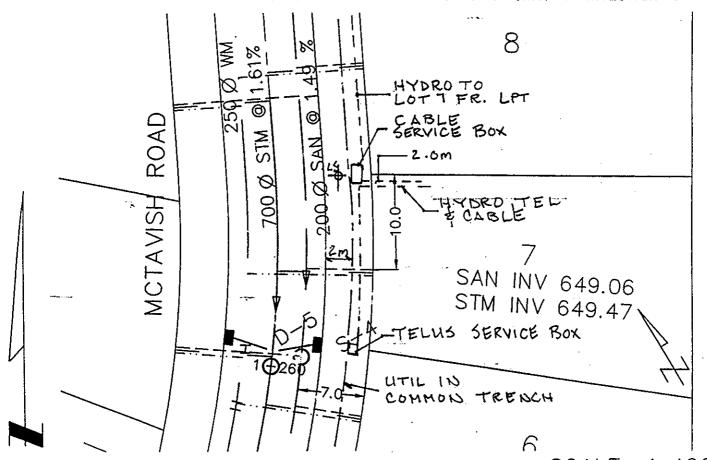

SCALE: 1:400