

City of Prince George
HISTORY SHEET

SHEET NUMBER

Roll Number 024478954

Legal: LOT'S 12 BLOCK D.L. 4377 PLAN PG43880

Address: 2354 MCTAVISH ROAD

Sanitary Connection: # SIZE 100 mm MATERIAL PVC INV. 652.55 CONNECTED

Water Connection # SIZE 25 mm MATERIAL CU METER CONNECTED

Storm Connection: # SIZE 100 mm MATERIAL PVC INV. 652.58 CONNECTED

Cash Receipt No's: WATER SANITARY STORM

CURB FROM PROPERTY LINE PAVEMENT WIDTH

I.C. HYDRO UNDERGROUND CONNECTION


B.C. TELEPHONE UNDERGROUND CONNECTION

LAND GAS

Information Sheets:

Comments:

THE INFORMATION CONTAINED HEREIN IS FOR INTERNAL USE ONLY.
NOT TO BE RELIED UPON UNLESS CONFIRMED BY SITE INSPECTION AND/OR INVESTIGATION

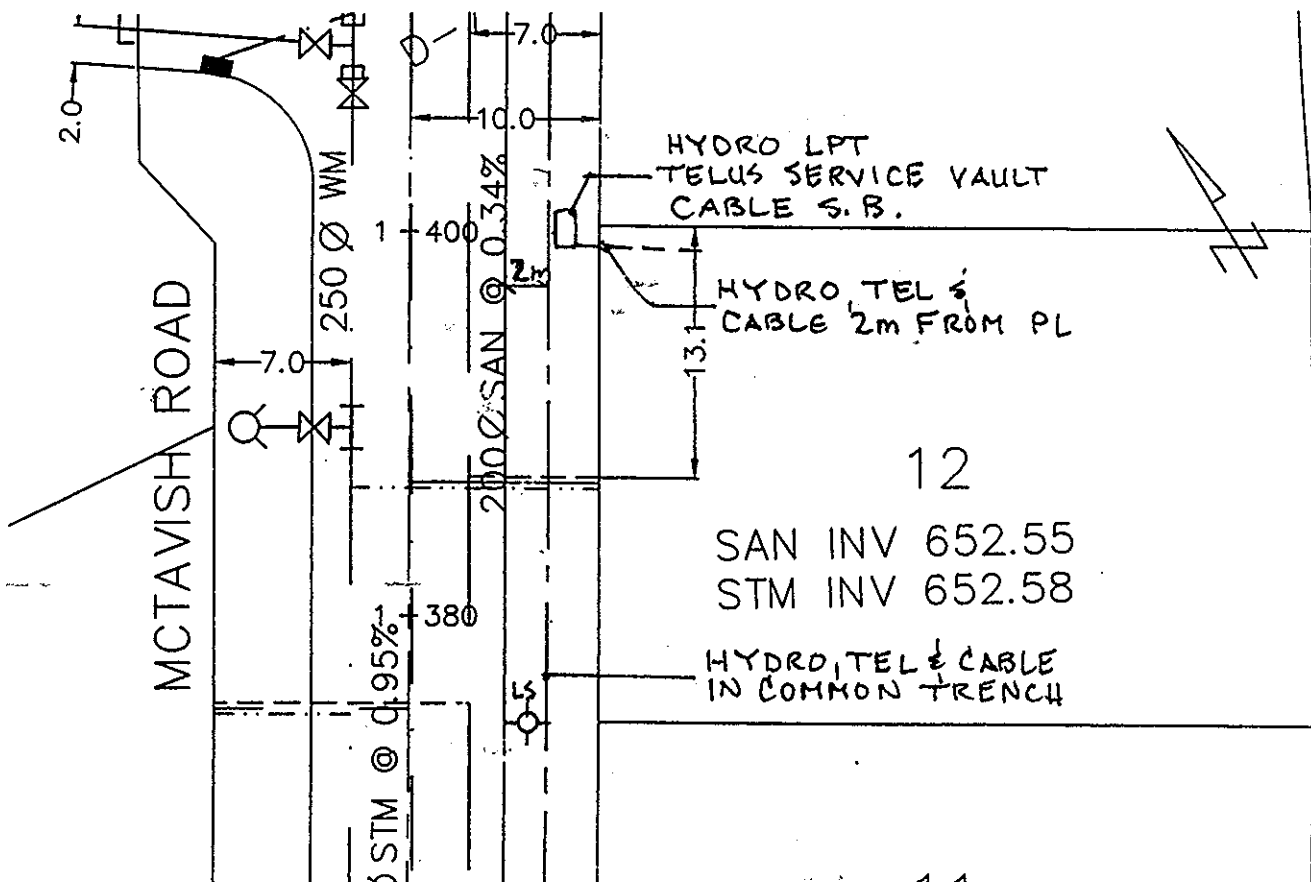

SCALE: 1:400