

City of Prince George
HISTORY SHEET

Roll Number 024479004

SHEET NUMBER

Legal: LOT'S 17 BLOCK D.L. 4377 PLAN PG43880

Address: 2387 MCTAVISH ROAD

Sanitary Connection: # SIZE 100mm MATERIAL PVC INV. 656.00 CONNECTED

Water Connection # SIZE 25mm MATERIAL CU METER CONNECTED

Storm Connection: # SIZE 100mm MATERIAL PVC INV. 656.00 CONNECTED

Cash Receipt No's: WATER SANITARY STORM

CURB FROM PROPERTY LINE PAVEMENT WIDTH

I.C. HYDRO UNDERGROUND CONNECTION

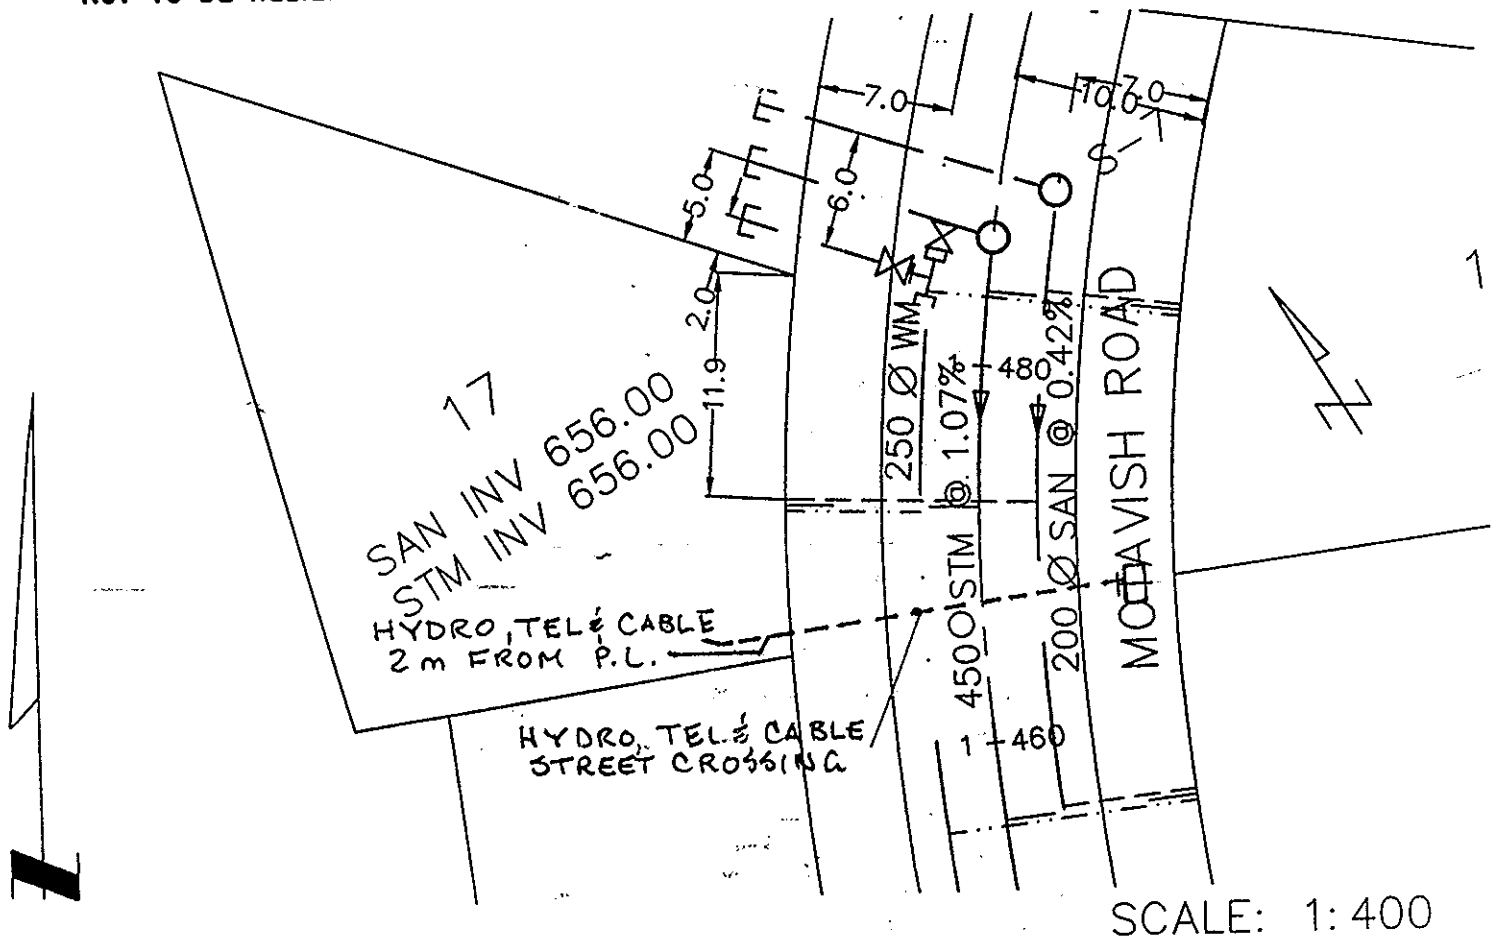
B.C. TELEPHONE UNDERGROUND CONNECTION

LAND GAS

Information Sheets:

Comments:

THE INFORMATION CONTAINED HEREIN IS FOR INTERNAL USE ONLY.
NOT TO BE RELIED UPON UNLESS CONFIRMED BY SITE INSPECTION AND/OR INVESTIGATION

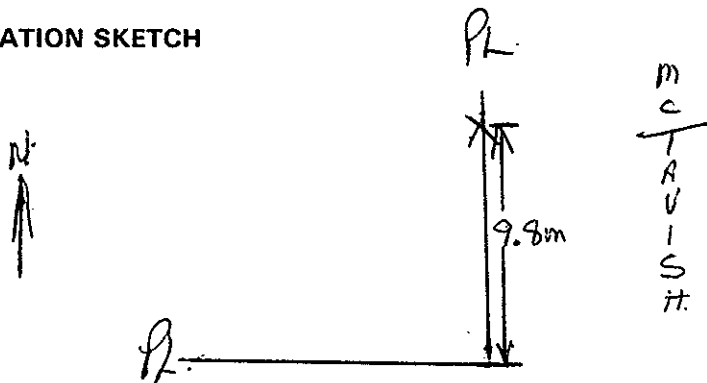


REPORT TO RECORDS

WATER SERVICE INFORMATION

Lot No. 17-4377-43880 Block _____ D.L. _____Address 2387 M^C TAVISH.Size of Connection ☐ 1/2" ☒ 3/4" ☐ Other _____Type of Connection ☒ Copper ☐ IronThaw Wire ☒ Yes ☐ No

LOCATION SKETCH

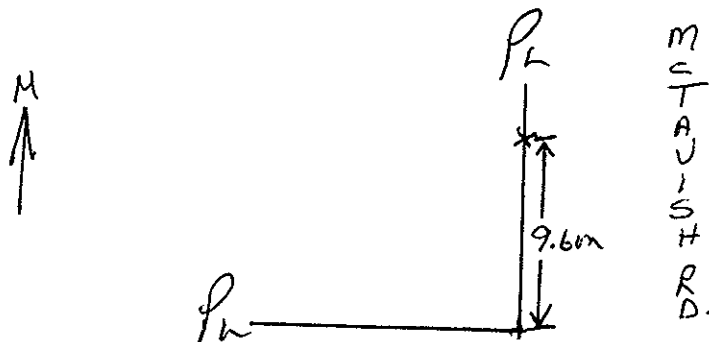
Field Location By L. Linko Date Nov. 17/00

Checked by: _____

REPORT TO RECORDS

SEWER SERVICE INFORMATION

Lot No. _____ Block _____ D.L. _____

Address 2387 M^CTAVISH.Size of Connection ☒ 100mm ☐ 150mm ☐ 200mm ☐ Other _____Type of Connection ☐ Transite ☒ PVC ☐ Other _____Type of Cap ☐ Transite ☒ Cast Iron**LOCATION SKETCH**Field Location By L. Panko Date Nov. 17/00

Checked by Foreman - Sewer Division _____