

City of Prince George HISTORY SHEET

024486094

SHEET NUMBER

PID #

Legal: LOTS PCL-A BLOCK 6 D.L. 932 PLAN 796

Address: 2105 PINE STREET

Sanitary Connection: # 6677 SIZE 100 mm MATERIAL A.C. INV. 568.572 CONNECTED

Water Connection: # 6716 SIZE 20 mm MATERIAL CU METER CONNECTED

Storm Connection: # SIZE mm MATERIAL INV. CONNECTED

Cash Receipt No's: WATER SANITARY STORM

CURB FROM PROPERTY LINE 5.791 m PAVEMENT WIDTH 12.801 m

B.C. HYDRO O/H UNDERGROUND CONNECTION


B.C. TELEPHONE O/H UNDERGROUND CONNECTION

INLAND GAS 4.572 m FROM EAST SIDE OF PINE ST.


Information Sheets:

Comments:

**THE INFORMATION CONTAINED HEREIN IS FOR INTERNAL USE ONLY.
NOT TO BE RELIED UPON UNLESS CONFIRMED BY SITE INSPECTION AND/OR INVESTIGATION**

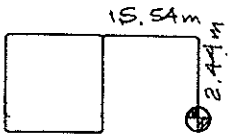

PORTER AVE.

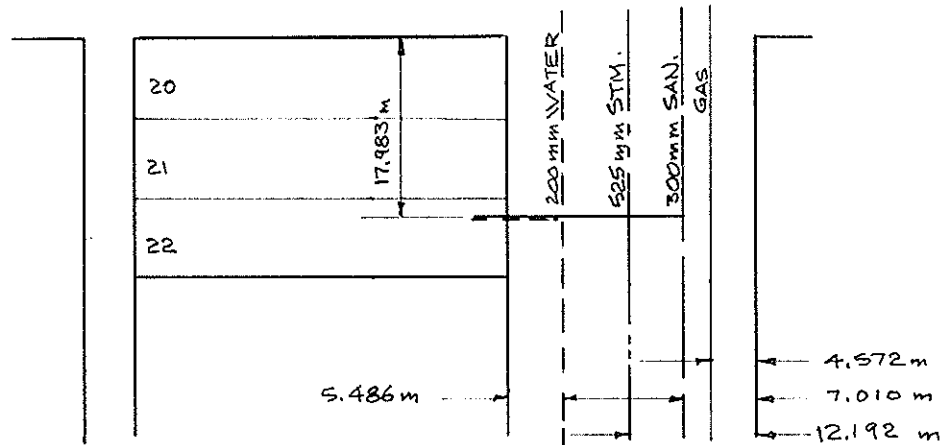

PINE ST.