



City of Prince George History Sheet

PID:	024497533
SD/MU:	
WO:	

Civic Address: 2233 McTavish Rd

Legal Description: Lot: 2 District Lot: 4377 Plan: PGP43968


Service Type	Diameter (mm)	Material	Invert Elev at main (m)	Invert Elev at property line (m)	Invert Elev at service end (m)	Distance into property (m)	Installation Date
Sanitary	100mm	PVC		642.24	642.24	0.00	1999
Water	25mm	Copper	-		-	-	1999
Storm	100mm	PVC	-	642.24	642.24	0.00	1999

Service Connection Location				Sanitary (m)	Storm (m)
Distance from downstream San MH	4808	towards upstream San MH	4807	13.50	
Distance from downstream Stm MH	11	towards upstream Stm MH	10		11.60

Power	Size	Communications	Size	Cable	Size	Gas	Size
BC Hydro	-	Telus	-	Shaw	-	FortisBC	-
Underground Service		Underground Service		Underground Service			

Installed by:	Survey Date:
Comments:	

NOT TO SCALE The information contained herein is for internal use only.
Not to be relied on unless confirmed by site inspection and/or investigation.

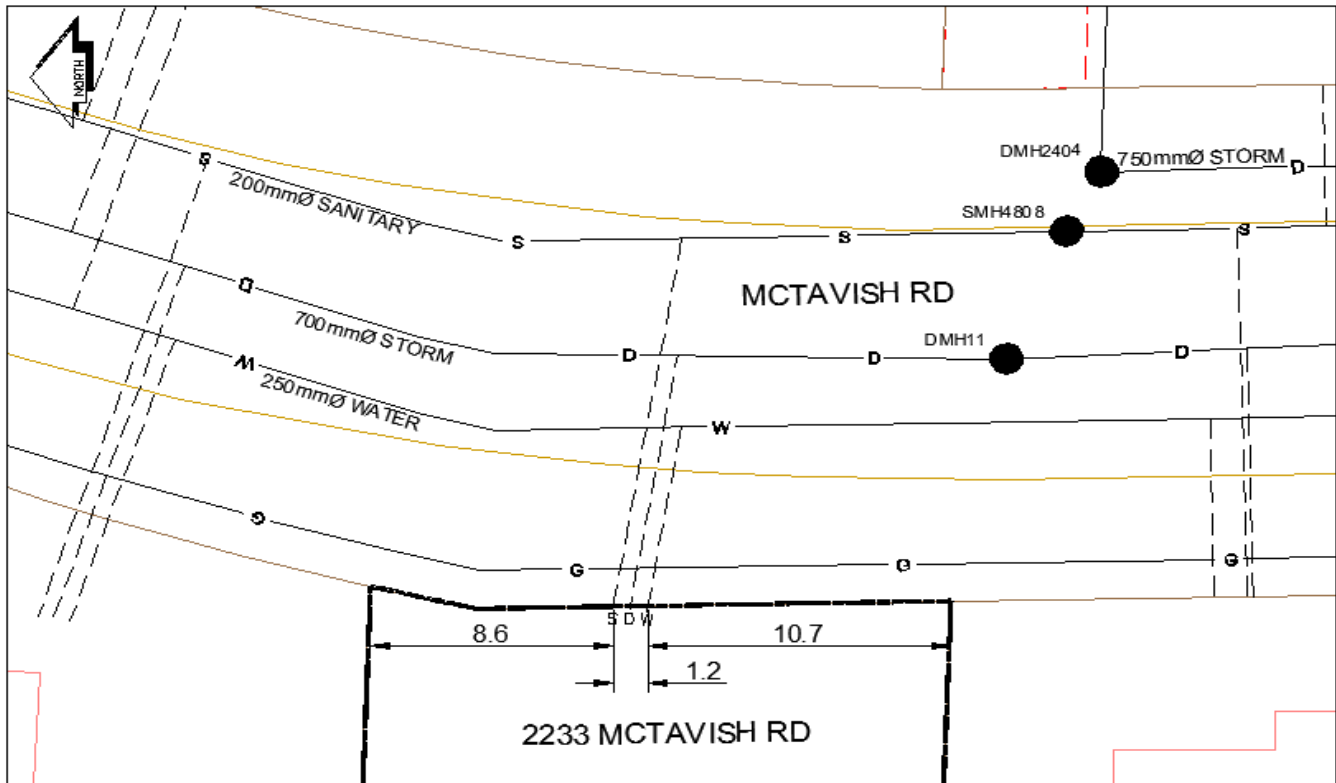

LE GEND:	CS ^o CURB STOP	--- WATER SERVICE	--- STORM SERVICE
	CO ^o CLEAN OUT	--- SANITARY SERVICE	--- GAS

NOT TO SCALE