



City of Prince George
History Sheet

| | |
|--------|-----------|
| PID: | 024497550 |
| SD/MU: | |
| WO: | |

Civic Address: 2255 McTavish Rd

Legal Description: Lot: 4 District Lot: 4377 Plan: PGP43968


| Service Type | Diameter (mm) | Material | Invert Elev at main (m) | Invert Elev at property line (m) | Invert Elev at service end (m) | Distance into property (m) | Installation Date |
|--------------|---------------|----------|-------------------------|----------------------------------|--------------------------------|----------------------------|-------------------|
| Sanitary | 100mm | PVC | - | - | 643.02 | - | 1999 |
| Water | 20mm | Copper | - | - | - | - | 1999 |
| Storm | 100mm | PVC | - | - | 643.02 | - | 1999 |

| Service Connection Location | | | | Sanitary (m) | Storm (m) |
|---------------------------------|------|-------------------------|------|--------------|-----------|
| Distance from downstream San MH | 4808 | towards upstream San MH | 4807 | 46.00 | |
| Distance from downstream Stm MH | 11 | towards upstream Stm MH | 10 | | 29.00 |

| Power | Size | Communications | Size | Cable | Size | Gas | Size |
|---------------------|------|---------------------|------|---------------------|------|----------|------|
| BC Hydro | - | Telus | - | Shaw | - | FortisBC | - |
| Underground Service | | Underground Service | | Underground Service | | | |

| | |
|--|--------------|
| Installed by: | Survey Date: |
| Comments: Water service location confirmed September 2016. | |

NOT TO SCALE The information contained herein is for internal use only.
Not to be relied on unless confirmed by site inspection and/or investigation.

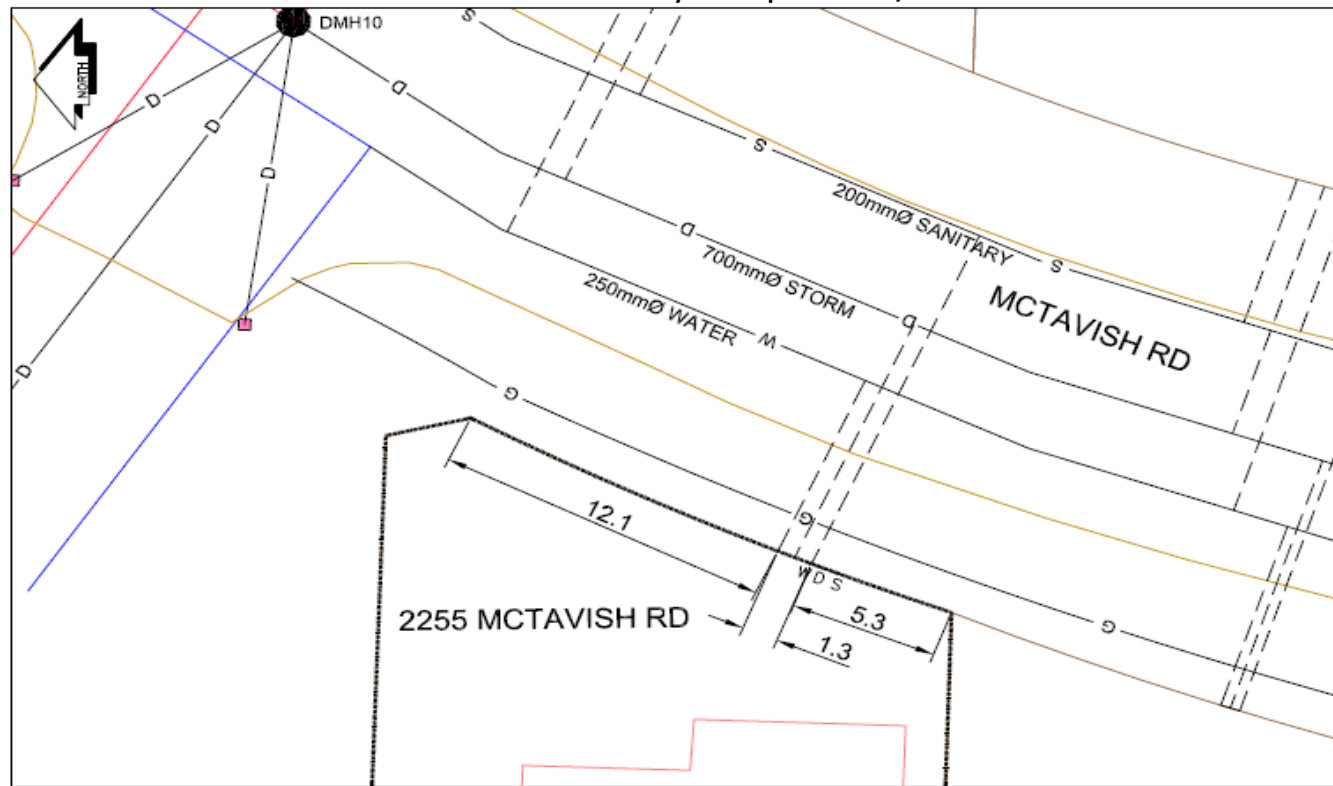

| | | | |
|---------|---------------------------|----------------------|-------------------|
| LEGEND: | CS ^o CURB STOP | --- WATER SERVICE | --- STORM SERVICE |
| | CO ^o CLEAN OUT | --- SANITARY SERVICE | --- G --- GAS |

NOT TO SCALE