

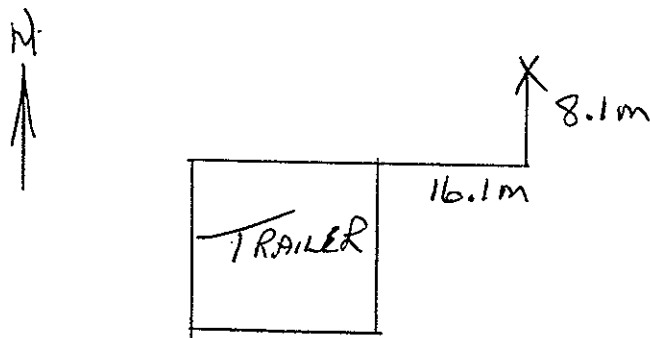
REPORT TO RECORDS

WATER SERVICE INFORMATION

Lot No. _____ Block _____ D.L. _____

Address 9079 VIKING RD.Size of Connection ☐ 1/2" ☒ 3/4" ☐ Other _____Type of Connection ☒ Copper ☐ IronThaw Wire ☒ Yes ☐ No

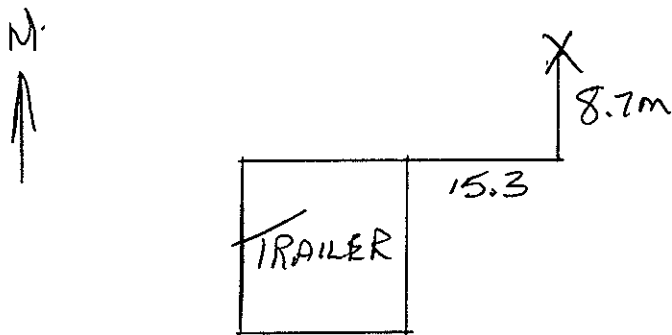
LOCATION SKETCH

Field Location By L. Panko Date Nov. 15/99

Checked by: _____

REPORT TO RECORDS

SEWER SERVICE INFORMATION

Lot No. 2-2432-44470 Block _____ D.L. _____Address 9079 VIKING RD.Size of Connection ☒ 100mm ☐ 150mm ☐ 200mm ☐ Other _____Type of Connection ☐ Transite ☒ PVC ☐ Other _____Type of Cap ☐ Transite ☒ Cast Iron**LOCATION SKETCH**Field Location By L. Linko Date Nov. 15/99

Checked by Foreman - Sewer Division _____