


Lot Servicing

4160 HOLLANDIA CRT

PID: 024741990

Lot: B, Plan: PGP45248, DL: 753

SERVICE	SIZE	MATERIAL	INSTALLED DATE	LOCATION	DETAILS
WATER	19MM	CU		FROM SW COR BLDG 7.0M W 1.2M S	
WATER	20MM	CU	15-Jun-2007	5.0M S OF NE PL	CASH RECEIPT NUMBER MU100713
SANITARY	100MM	PVC		1.0M S OF N PL	CLEANOUT 7.3M S OF N PL
SANITARY	100MM	PVC	15-Jun-2007	7.3M S OF NE COR PL	CONNECTION # 34616

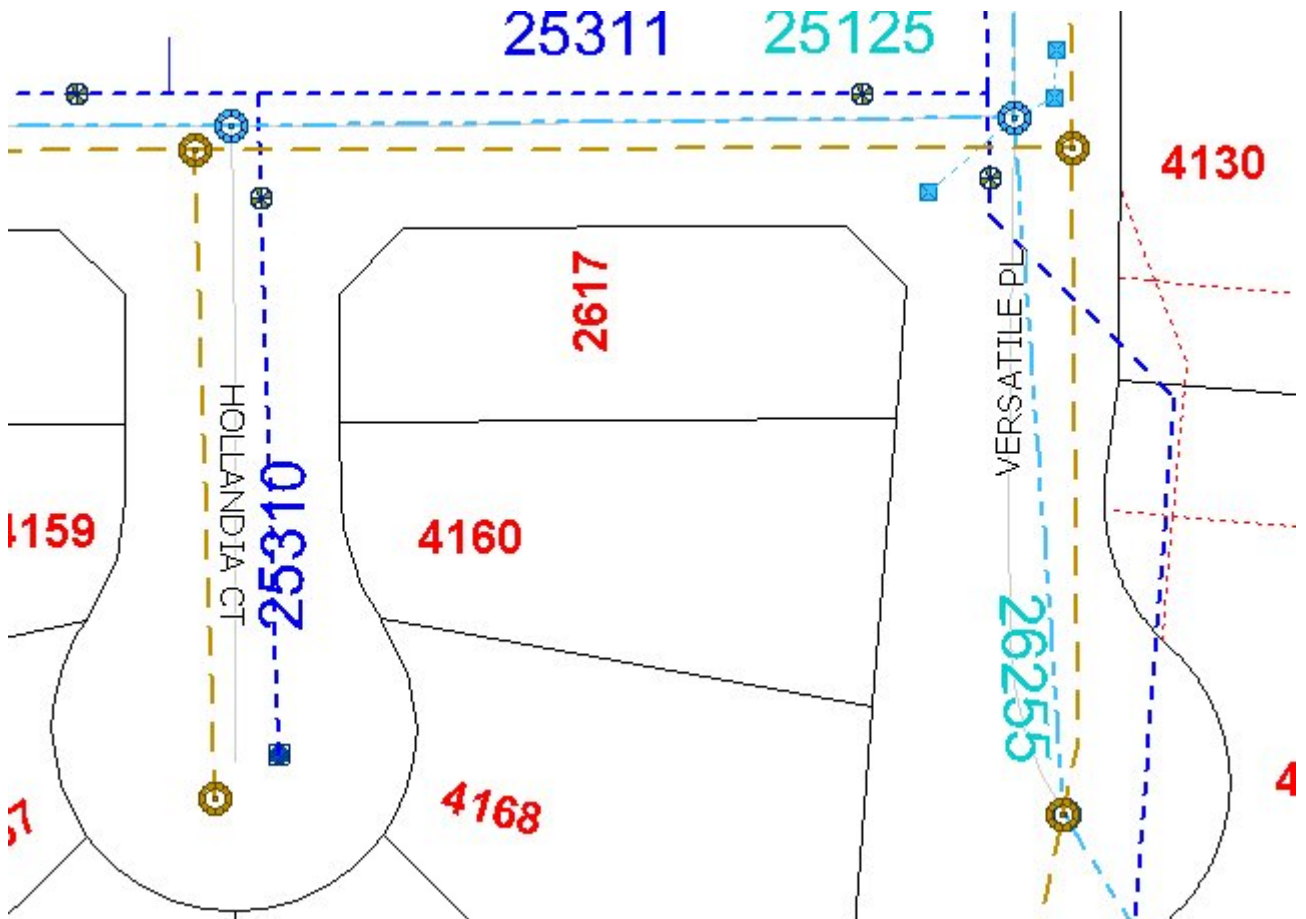

Accuracy not guaranteed unless confirmed by site inspection and/or investigation.
Connection location between main and property line only.

