

City of Prince George  
HISTORY SHEET

SHEET NUMBER 7 of 23

ROLL NUMBER 024914428

Legal: LOT 7

D.L. 1605

PLAN PGP46265

Address: 3302 VISTA VIEW ROAD

Sanitary Connection:# SIZE: 100mm $\phi$  MATERIAL: PVC INV. 683.88m CONNECTED

Water Connection:# FROM MAIN: 19 mm $\phi$  COPPER METER

Storm Connection:# SIZE 100mm $\phi$  MATERIAL PVC INV. 683.92m CONNECTED

Cash Receipt No's: WATER SANITARY STORM

CURB FROM PROPERTY LINE 5.0m PAVEMENT WIDTH 10.0m

B.C. HYDRO 75mm DB2 U/G CONNECTION ☒


B.C. TELEPHONE 100mm DB2 U/G CONNECTION ☒

B.C. GAS 42 PROP/P.E.


Information Sheets: REF. DWGS: L&M ENGINEERING LTD. JOB. 1106-03-03

Comments: ~~742.40~~ PROPOSED FINAL LOT CORNER ELEVATION  
741.90 EXISTING GUTTER ELEVATION


THE INFORMATION CONTAINED HEREIN IS FOR INTERNAL USE ONLY.  
NOT TO BE RELIED UPON UNLESS CONFIRMED BY THE SITE INSPECTION AND/OR INVESTIGATION

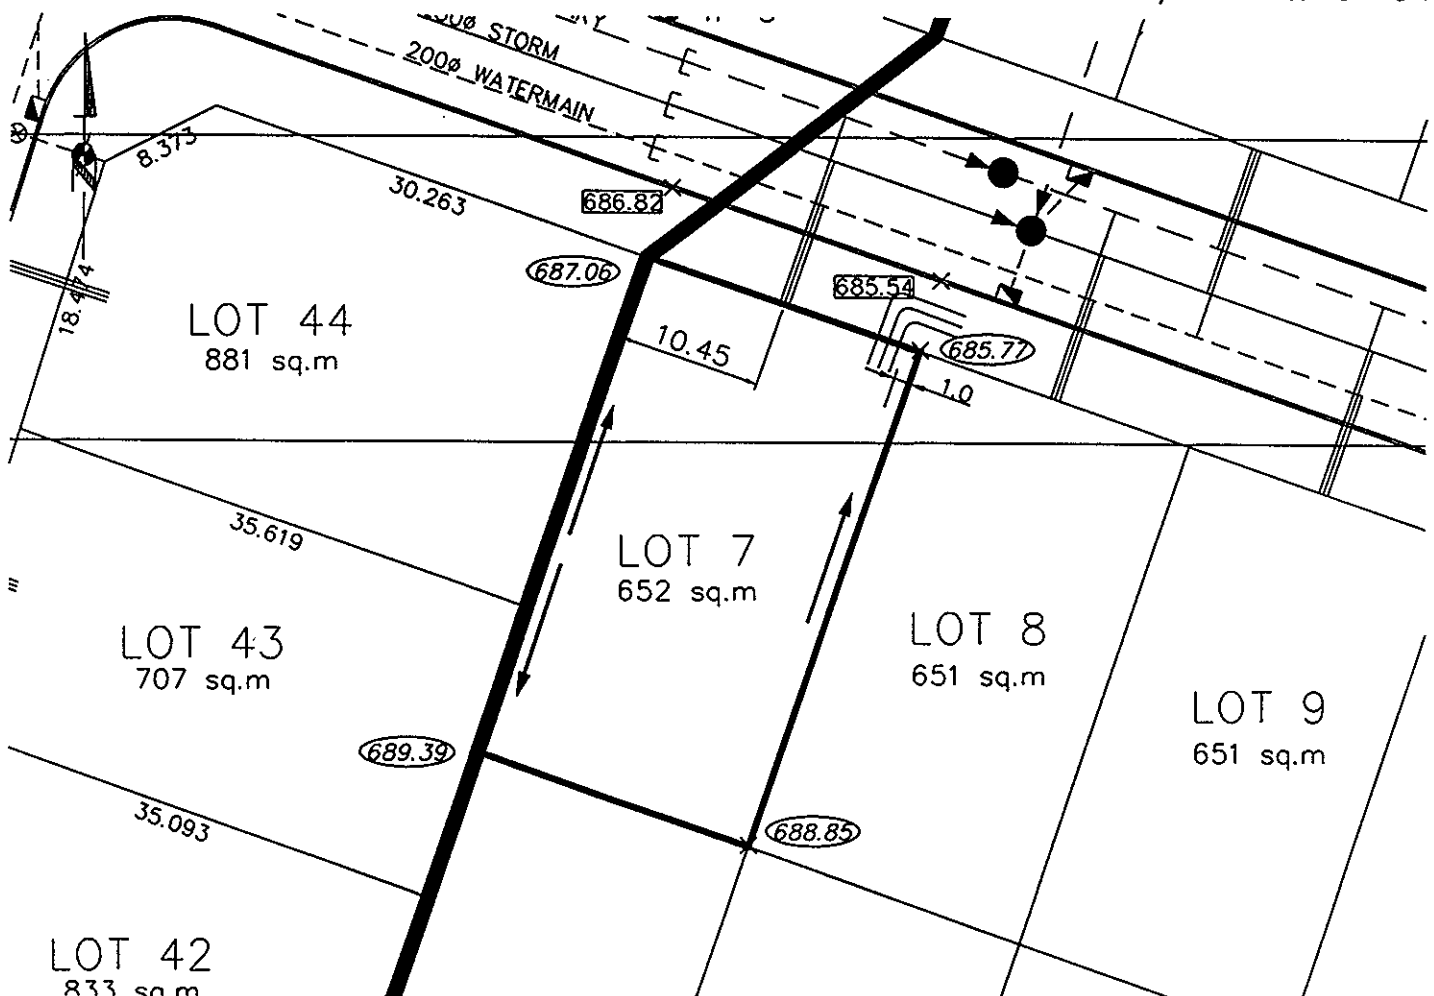

# UTILITY OPERATIONS CONNECTION INSPECTION FORM


|   |   |  |
|---|---|--|
| Property Address: <u>3302 VISTA VIEW</u>  |   | Lot # _____  |
| Native Soil: <u>CLAY</u>  | Backfill Material: <u>CLAY</u>            |  |
| Diagram of Location:  | Water <input checked="" type="checkbox"/> | Sanitary <input checked="" type="checkbox"/> Storm _____ |
| See over for diagrams  76277 |   |  |

## WATER INSPECTION
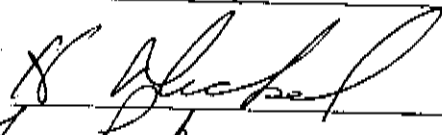
|   |   |
|---|---|
| City Pipe Material: <u>COPPER</u>   | Private Pipe Material: <u>PLASTIC</u>             |
| Fittings: _____   | Size: <u>20</u> mm                                |
| Comments: _____   | Thaw Wire: OK <input checked="" type="checkbox"/> |
| S.P. O.K.   |   |
| Inspected by City Building Inspector:  | Date: <u>OCT 1/04</u>                             |
| Inspected By: <u>L. Lunko</u>   | Date: <u>OCT 1/04</u>                             |


LOCATES: 

## STORM INSPECTION
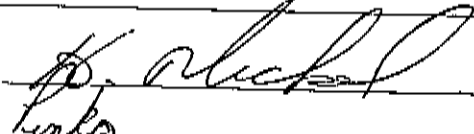
|  |                                     |
|--|-------------------------------------|
| City Pipe Material: <u>P.V.C</u>   | Private Pipe Material: <u>P.V.C</u> |
| Fittings: _____  | Size: <u>100</u> mm                 |
| Comments: _____  |                                     |
| Inspected by City Building Inspector:  | Date: <u>OCT 1/04</u>               |
| Identified By: <u>L. Lunko</u>   | Date: <u>OCT 1/04</u>               |

LOCATES: 

## SANITARY IDENTIFICATION 1 (At Property Line)
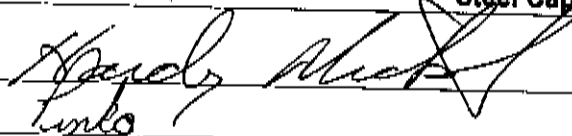
|  |                                     |
|--|-------------------------------------|
| City Pipe Material: <u>P.V.C</u>   | Private Pipe Material: <u>P.V.C</u> |
| Dye Test 1: Pass <input checked="" type="checkbox"/> Fail _____  | Fittings: _____                     |
| Comments: _____  | Size: <u>100</u> mm                 |
| Steel Cap on Cleanout? <input type="checkbox"/> Yes <input checked="" type="checkbox"/> No                                 |                                     |
| Inspected by City Building Inspector:  | Date: <u>OCT 1/04</u>               |
| Identified by: <u>L. Lunko</u>   | Date: <u>OCT 1/04</u>               |

## SANITARY IDENTIFICATION 2 (Final)

|   |             |
|---|-------------|
| Dye Test 2: Pass _____ Fail _____   |             |
| Comments: _____   |             |
| Steel Cap on Cleanout? <input type="checkbox"/> Yes <input type="checkbox"/> No |             |
| Inspected by City Building Inspector: _____                                     | Date: _____ |
| Identified By: _____  | Date: _____ |

**Note:** Sanitary Inspection 1 at property line is to be inspected and approved to reduce the risk of a cross connection. The Final Sanitary Inspection is required before occupancy to ensure a cross connection has not occurred between the property line and the building.


# UTILITY OPERATIONS

9.7

## Water Service Information

Size of Connection ☐ 1/2" ☒ 3/4" ☐ Other Type of Connection ☒ Copper ☐ Iron  
 Thaw Wire ☒ Yes ☐ No


### Location Sketch

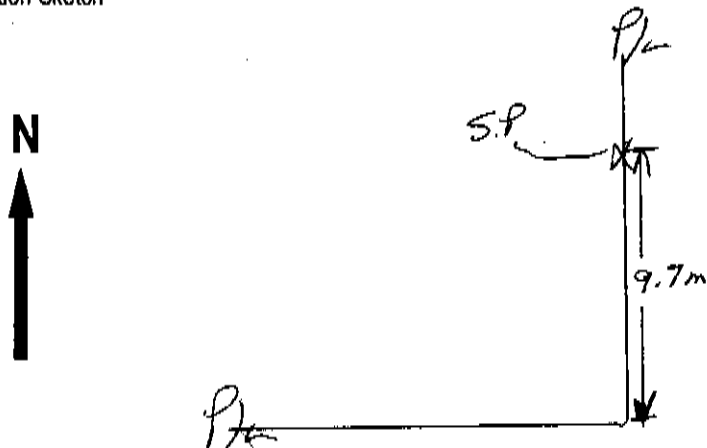

## Storm Connection

Size of Connection ☒ 100mm ☐ 150mm ☐ Other ☐ 200mm ☐ Other  
 Type of Connection ☐ Transite ☒ PVC ☐ Other  
 Type of Cap ☐ Transite ☒ Cast Iron

### Location Sketch

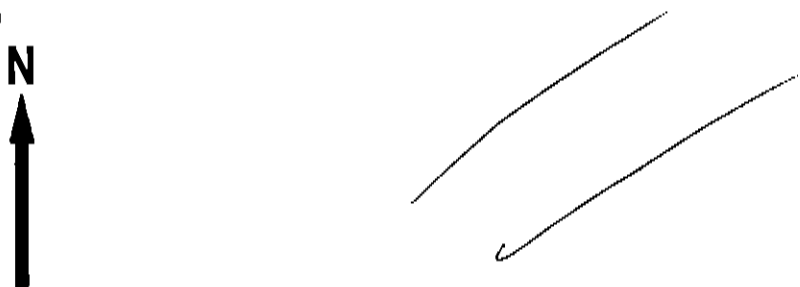

## Sewer Connection

Size of Connection ☒ 100mm ☐ 150mm ☐ Other ☐ 200mm ☐ Other  
 Type of Connection ☐ Transite ☒ PVC ☐ Other  
 Type of Cap ☐ Transite ☒ Cast Iron

### Location Sketch

