



# City of Prince George History Sheet

PID:	025153650
MU:	100089
WO:	01-P14

Civic Address: 2175 9th Ave

Legal Description: Lot: 1 District Lot: 343 Plan: PGP47151


Service Type	Diameter (mm)	Material	Invert Elev at main (m)	Invert Elev at property line (m)	Invert Elev at service end (m)	Distance into property (m)	Installation Date
Sanitary (S1)	150mm	PVC	-	-	-	-	October 2001
Sanitary (S2)	200mm	AC	-	-	-	-	October 1958
Water (W1)	150mm	PVC	-	-	-	-	September 2001
Water (W2)	20mm	Copper	-	-	-	-	October 1958
Storm (D1)	150mm	Vit	-	-	-	-	October 1958
Storm (D2)	200mm	Vit	-	-	-	-	October 1958

Service Connection Location	Sanitary (m)	Storm (m)
150mm Sanitary service connected to San MH5516		
Distance from downstream San MH 3075 towards upstream San MH 1986	34.65	
150mm Storm service connected to Stm MH13		
200mm Storm service connected to Stm MH13		

Power	Size	Communications	Size	Cable	Size	Gas	Size
BC Hydro	-	Telus	-	Shaw	-	FortisBC	-
Underground Service		Underground Service		Underground Service			

Installed by:	City of Prince George forces	Survey Date:	-
Comments:	Water service location confirmed July 16, 2019		
W1 and S1 locations confirmed January 28, 2003.			

**NOT TO SCALE** The information contained herein is for internal use only.  
Not to be relied on unless confirmed by site inspection and/or investigation.

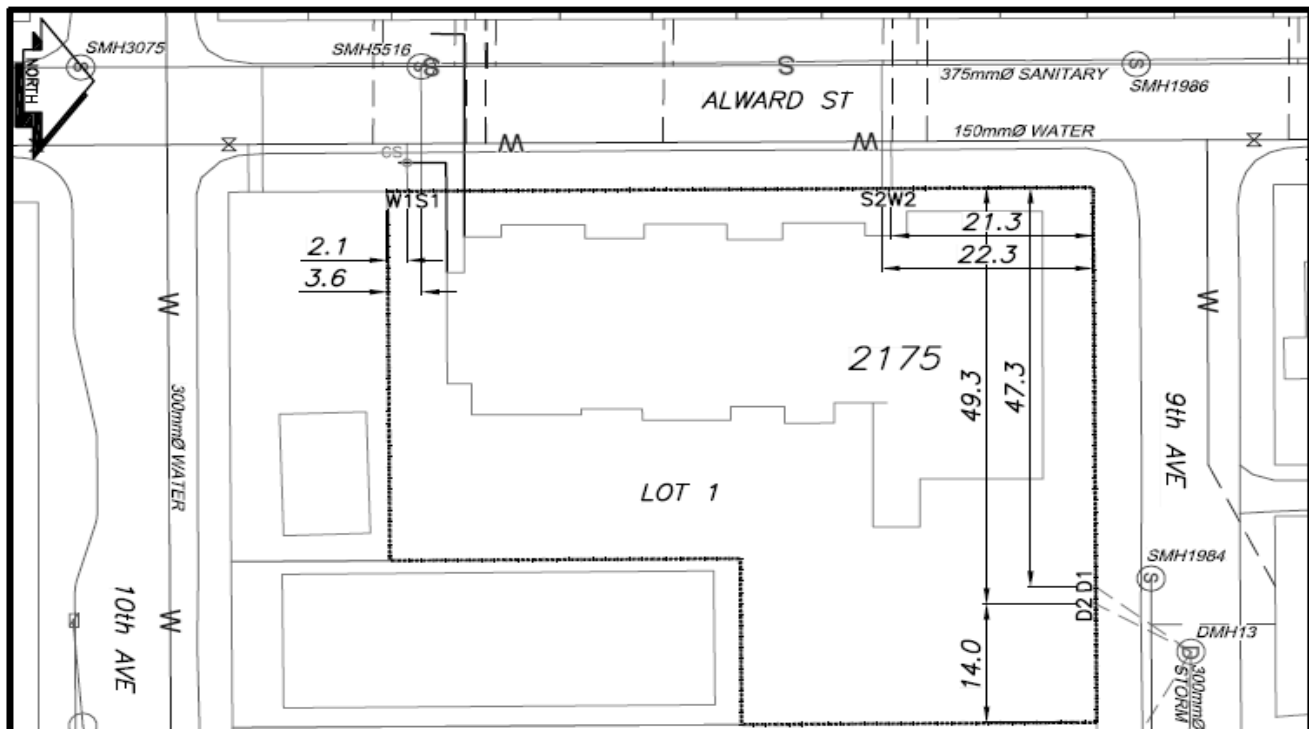

CS <sup>o</sup> CURB STOP	--- W WATER SERVICE	--- S SANITARY SERVICE	--- D STORM SERVICE
CO <sup>o</sup> CLEAN OUT	--- G GAS	--- ENCUMBRANCE	
WATER VALVE	--- FIRE HYDRANT		

**NOT TO SCALE**