



City of Prince George
History Sheet

PID:	025586998
SD/MU:	
WO:	10829/10831
	12149

Civic Address: 5959 O'Grady Rd

Legal Description: Lot: 2 District Lot: 2003 Plan: BCP3565

Service Type	Diameter (mm)	Material	Invert Elev at main (m)	Invert Elev at property line (m)	Invert Elev at service end (m)	Distance into property (m)	Installation Date
Sanitary	150mm	PVC	-	-	-	-	April 2003
Water	200mm	PVC	-	-	-	-	April 2003
Storm	300mm	PVC	-	-	-	-	June 2006

Service Connection Location	Sanitary (m)	Storm (m)
150mm Sanitary Service connected to San MH4916	-	
Distance from downstream Stm MH - towards upstream Stm MH -		


Power	Size	Communications	Size	Cable	Size	Gas	Size
BC Hydro	-	Telus	-	Shaw	-	FortisBC	-
Underground Service		Underground Service		Underground Service			

Installed by:	Survey Date:	-
Comments:		

NOT TO SCALE The information contained herein is for internal use only.
Not to be relied on unless confirmed by site inspection and/or investigation.

See drawing on following page

NOT TO SCALE

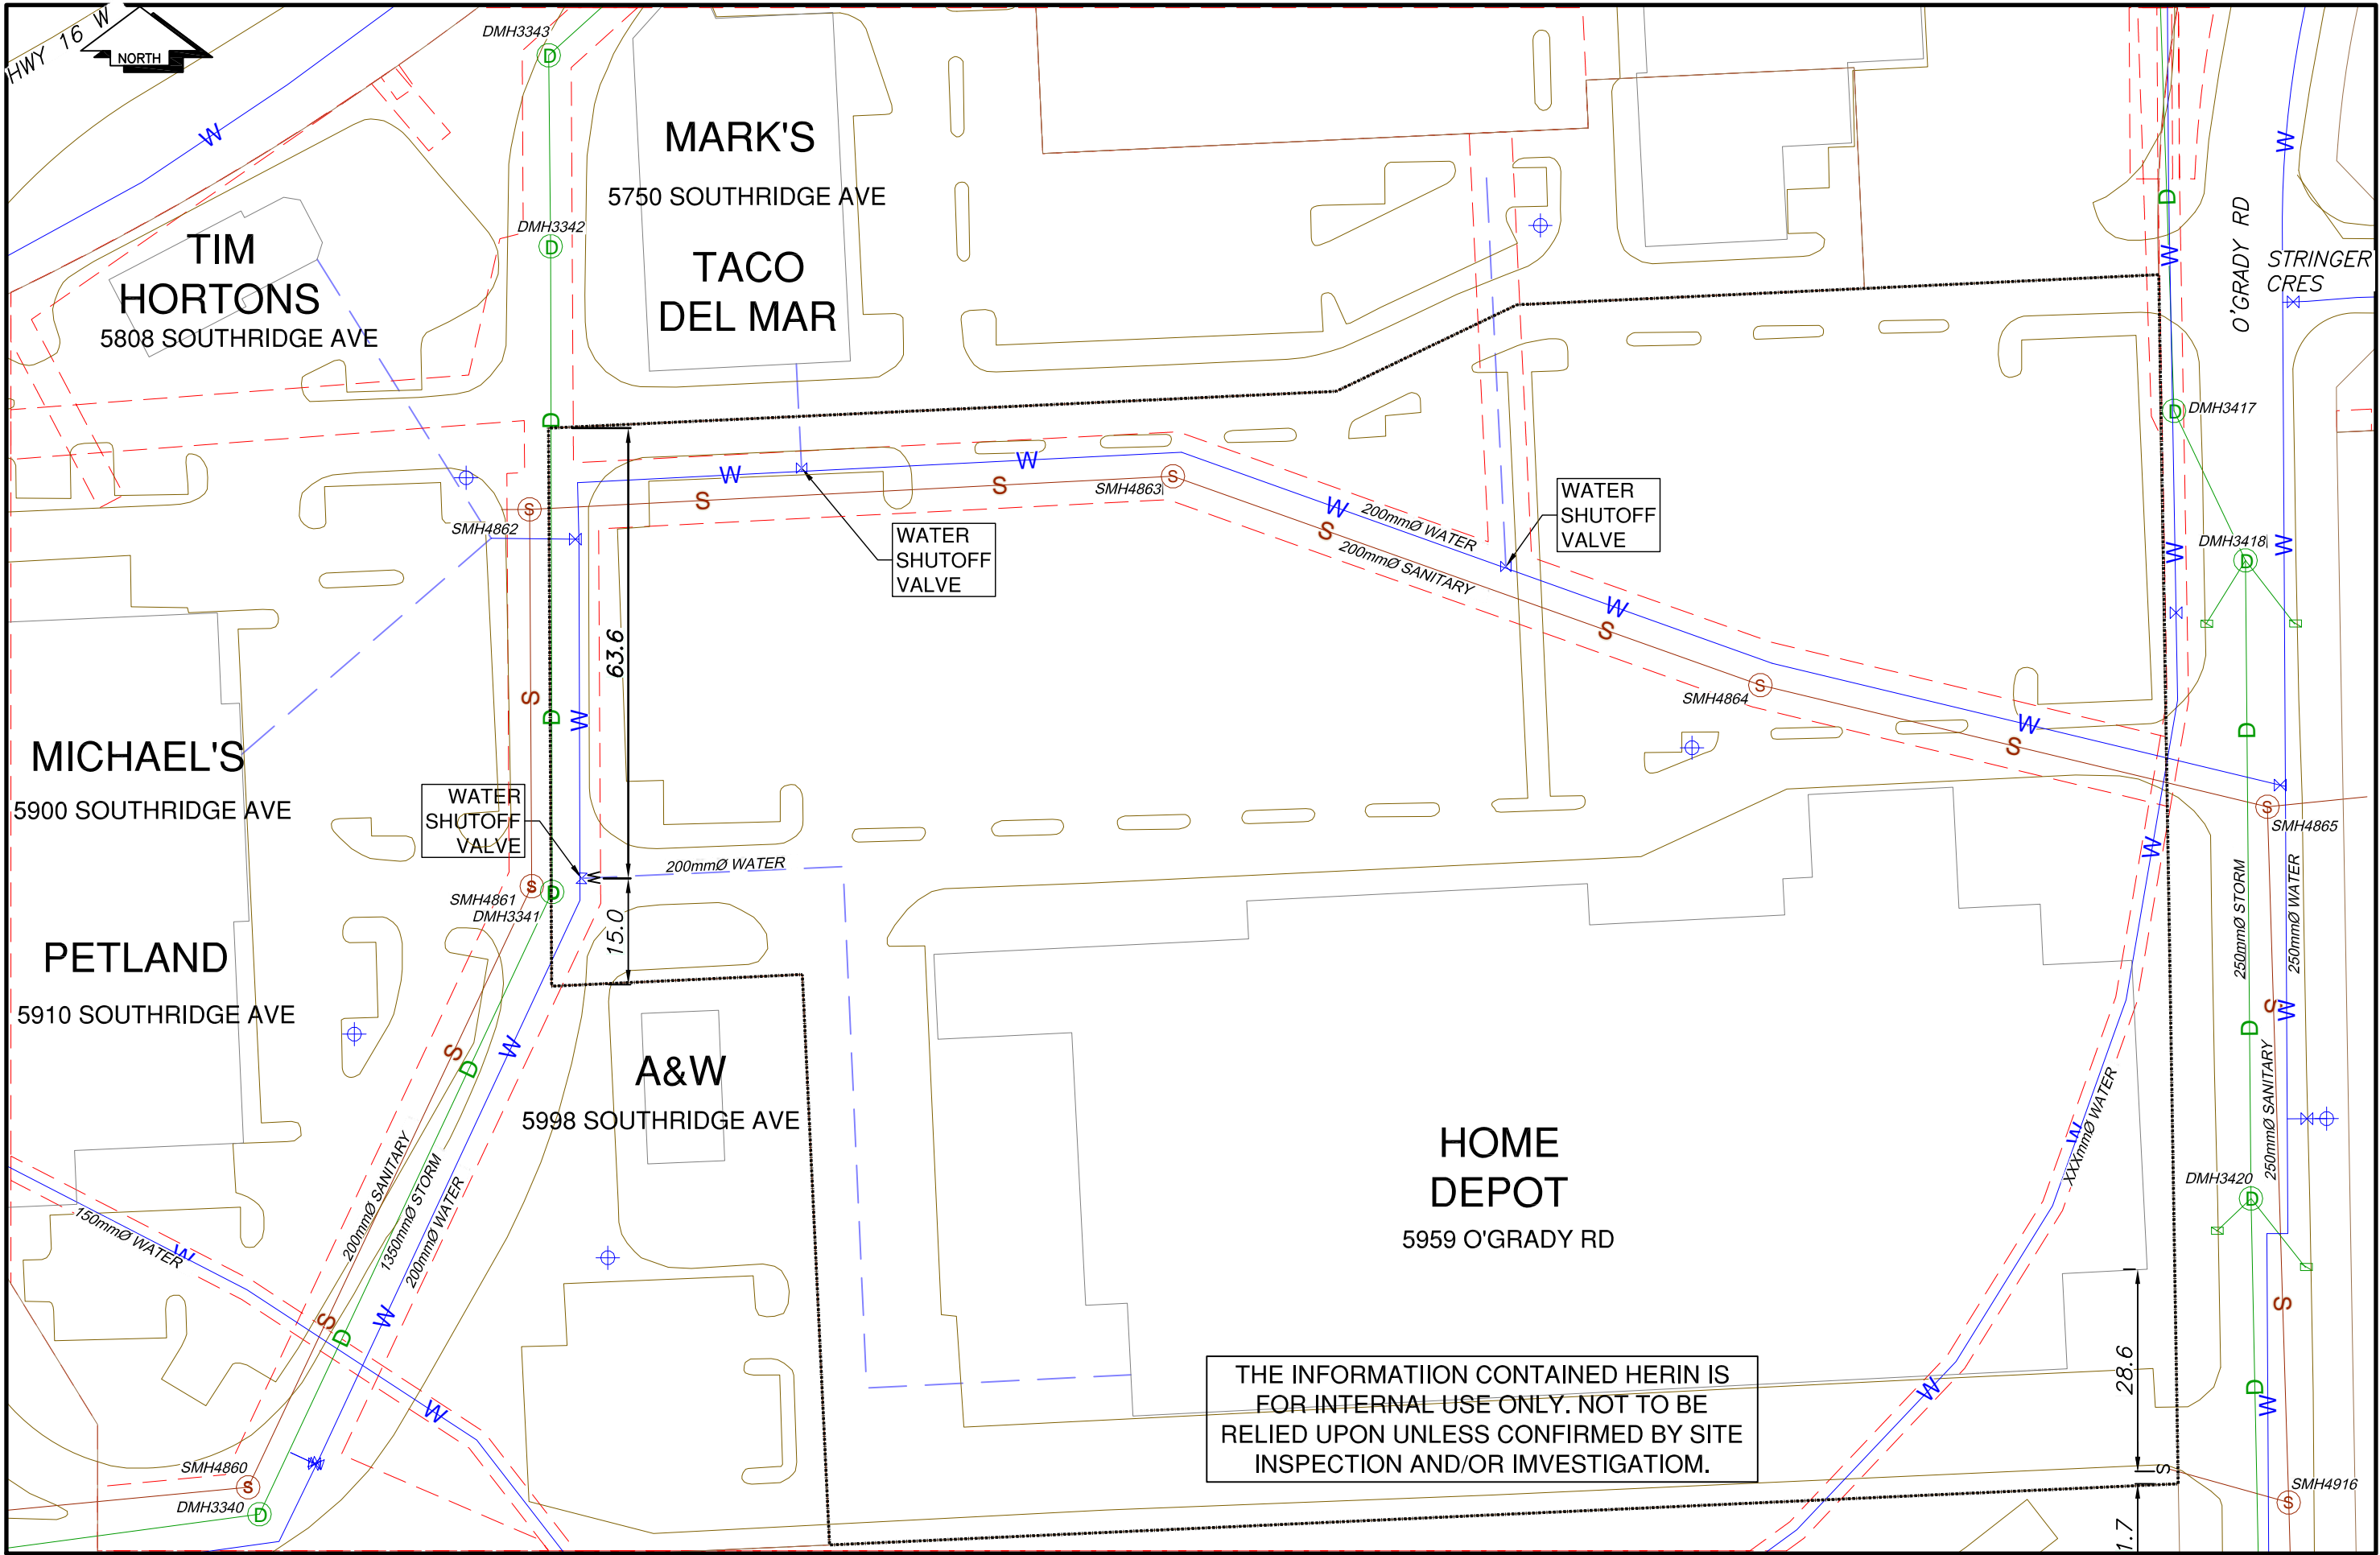

LEGEND:	CS	CURB STOP	— W	WATER SERVICE	— D	STORM SERVICE
	CO	CLEAN OUT	- - - S	SANITARY SERVICE	— G	GAS