


City of Prince George

HISTORY SHEET

SHEET NUMBER		PID # 025980131			
Legal:	LOTS 2	BLOCK	D.L. 937	PLAN	BCP12181
Address: 660 Central St. E					
Sanitary Connection:	# 4361 1854	SIZE 100 -	mm	MATERIAL AC -	INV. CONNECTED
Water Connection:	# 4136 3061	SIZE 40 19	mm	MATERIAL CU CU	METER CONNECTED
Storm Connection:	#	SIZE	mm	MATERIAL	INV. CONNECTED
Cash Receipt No's:	WATER	SANITARY	STORM		
CURB FROM PROPERTY LINE			PAVEMENT WIDTH		
B.C. HYDRO	UNDERGROUND CONNECTION				
B.C. TELEPHONE	UNDERGROUND CONNECTION				
INLAND GAS					
Information Sheets:					
Comments:					

**THE INFORMATION CONTAINED HEREIN IS FOR INTERNAL USE ONLY.
NOT TO BE RELIED UPON UNLESS CONFIRMED BY SITE INSPECTION AND/OR INVESTIGATION**

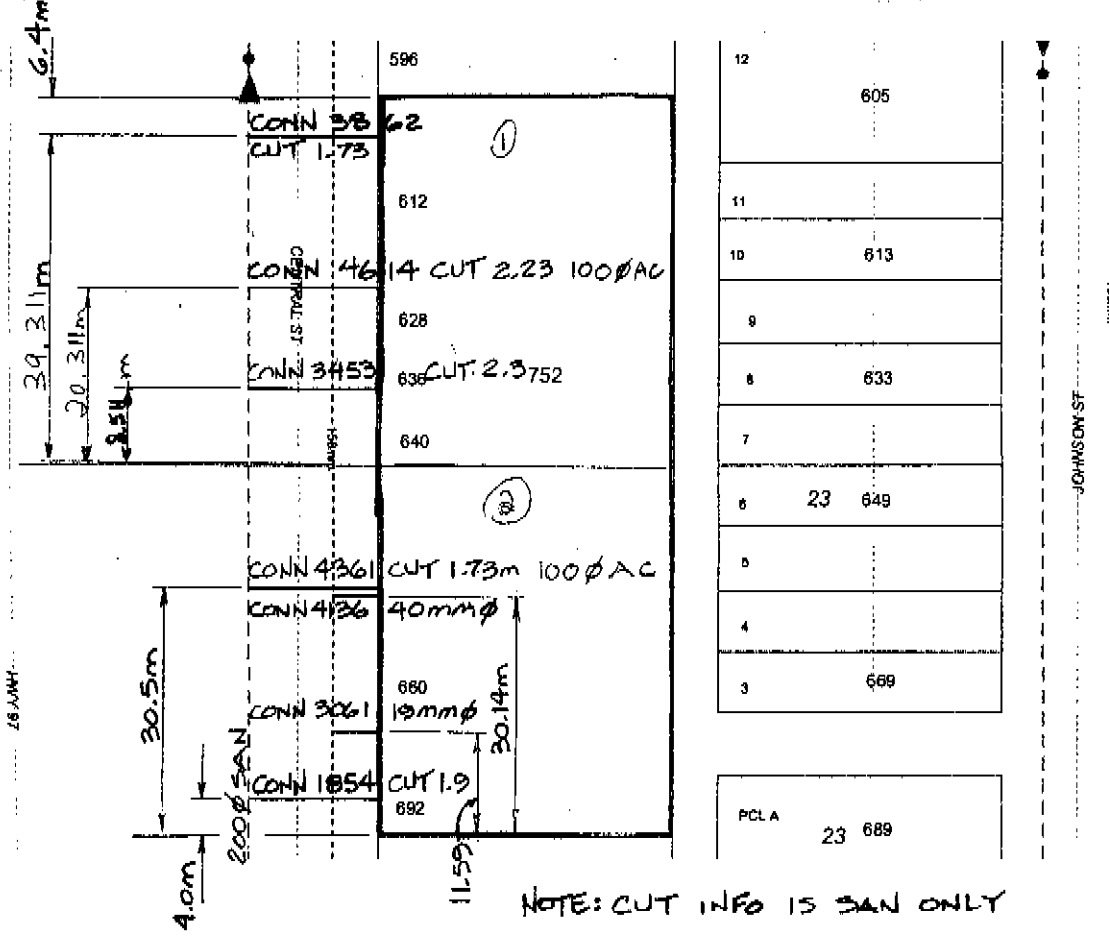

NOTE: CUT INFO IS SAN ONLY