

City of Prince George
HISTORY SHEET

now 34383

SHEET NUMBER **5351** Roll Number **025981129**

PARCEL D (PLAN BCP10773) OF PART PARCEL 1 DISTRICT LOT 745 PLAN 34384 AS SHOWN ON PLAN PGP35183

Legal: LOT'S BLOCK D.L. PLAN

Address: **1221 Terminal Blvd** *R.C.F. New Office Building*

Sanitary Connection: # SIZE MATERIAL INV. CONNECTED

Water Connection # *12392* SIZE *1 1/2"* MATERIAL METER CONNECTED

Storm Connection: # SIZE MATERIAL INV. CONNECTED

Cash Receipt No's: WATER *2127* SANITARY STORM

CURB FROM PROPERTY LINE PAVEMENT WIDTH

B.C. HYDRO UNDERGROUND CONNECTION


B.C. TELEPHONE UNDERGROUND CONNECTION

INLAND GAS

Information Sheets:

Comments:

SITE PLAN N.T.S.

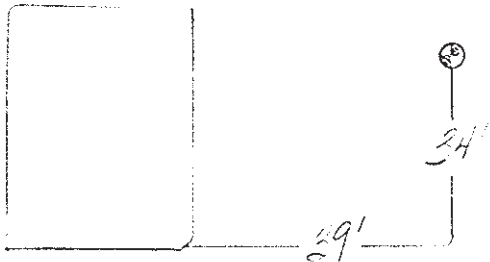

Terminal Building on Terminal Ave.

The information contained herein is
for internal use only. Not to be
relied upon unless confirmed by site
inspection and/or investigation.